

SURVEY & REMONUMENTATION

MAR 03 1998

KENT COUNTY REMONUMENTATION

SECTION

LAND CORNER RECORDATION CERTIFICATE
Filing Requirement of Act 74, Mich. P.A. 1970

For corners in
KENT COUNTY

Located In: Corner Code #

1. Public Land Survey	T 6N R 9W	E-6
	T R	
	T R	
	T R	
2. Property Controlling in Section	S T R	
	S T R	
3. Miscellaneous Property in Sec.	S T R	
	S T R	

REG. OF DEEDS
97 APR 29 AM 8:21
STATE OF MICHIGAN
COUNTY OF KENT
RECEIVED FOR RECORD


9821

Register of Deeds Stamp & File Number

4. Lot No. _____, Recorded Plat _____
5. Private Claims _____

I, Kirk Breitels, in a field survey on Jan. 7, 1997 do hereby state that under requirements of P.A. 74, Michigan P.A. of 1970, the corner points mentioned in lines 1 and 2 above were in conformance with regulations and rules therefore as required in the current manual of survey instructions of the United States Department of the Interior, Bureau of Land Management or by a decree of a Court of Law and for that the corner points mentioned in lines 3, 4 and 5 above were in conformance with the rules of the Michigan Board of Land Surveyors or by a Decree of a Court of Law, established, re-established, monumented, recovered, found as expressed below:

NOTE: Not more than 2 corners, all in the same town and range, may be recorded on this certificate.

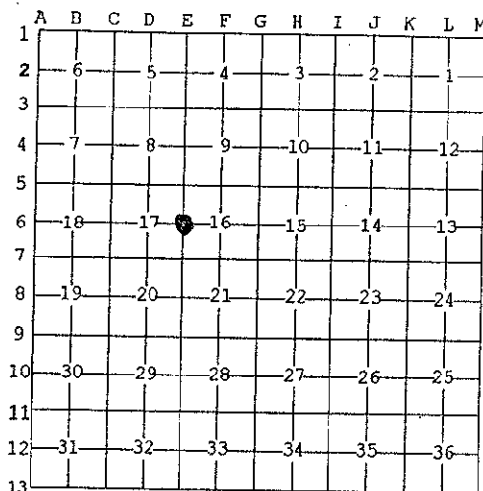

A. Description of original monument and accessories and/or subsequent restoration:

E-6	1830	GLO	Mullett	Set Post
	1933	Kent Co. Wit.		Iron
	1980	LCRC #1342	Merdzinski	5/8" Iron
	1980	LCRC #1402	Merdzinski	5/8" Iron
	1982	LCRC #3288	Hay	Set Kent County Monument
	1995	LCRC #8195	Breitels	Kent County Monument

The position of this corner was previously approved by the Kent County Remonumentation Peer Group, monumented by C. S. Hay on 5/12/82 and was recorded per LCRC #3288.

B. Description of corner evidence found and/or method applied in restoring or reestablishing corner:


E-6 Found standard Kent Co. Mon. (Harrison) per witnesses from above LCRC as set by C. S. Hay in place of the 5/8" Iron he found. Said Iron checks with Kent Co. Wit. and LCRC's #1342 & #1402.

LCRC #3288		LCRC #8195	
Nail & tag MBT Pole	S80°W 42.01'	Nail & tag MBT Pole	S80°W 42.01'
Nail & tag 24" Oak	N25°W 69.76'	Large spike 36" Oak	N25°W 69.77'
Nail & tag 24" Butternut	S40°W 49.19'	Nail & tag 24" Butternut	S40°W 48.95'
Nail & tag 18" Oak	S25°W 69.18'	Large spike 24" Oak	S25°W 69.29'
Nail & tag 20" Oak	S15°E 82.94'	Nail & tag 30" Oak	S15°E 82.80'

The selected location is accepted by me and is generally accepted by professional surveyors as the best available evidence of the position of the original corner.

C. Description of monument for corner and accessories established to perpetuate locating the position of the corner:

E-6 Standard Kent County Monument	
Nail & KC Remon. tag N. side MBT Pole	S80°W 42.01'
Large spike E. side 36" Oak	N25°W 69.77'
Nail & KC Remon. tag SE side 24" Butternut	S40°W 48.95'
Large spike SE side 24" Oak	S25°W 69.29'
Nail & KC Remon. tag W. side 30" Oak	S15°E 82.80'
C/L of gravel road is 10' West	
Top of monument is 8" under ground	

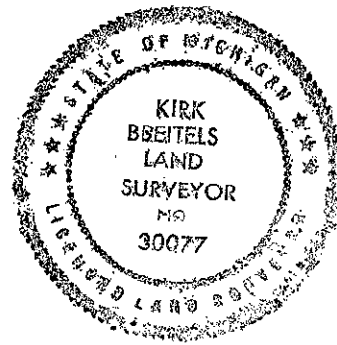

Signed by Kirk Breitels
Surveyor's Michigan License No. 30077

Date 3/27/97

P.A. 345 1990 KENT COUNTY

PEER APPROVED 3/27/97

CHAIRMAN Harry Huber

FORM APPROVED BY MICHIGAN STATE BOARD OF PROFESSIONAL SURVEYORS, JAN. 28, 1971
REVISED MAY 14, 1975
REVISED JAN., 1983
REVISED OCT., 1985