

SURVEY & REMONUMENTATION

MAR 03 1998

KENT COUNTY REMONUMENTATION

SECTION

LAND CORNER RECORDATION CERTIFICATE
Filing Requirement of Act 74, Mich. P.A. 1970

For corners in
KENT COUNTY

(County)

Located In:

Corner Code #

1. Public Land Survey

T 6N R 9W E-7

T _____ R _____

T _____ R _____

T _____ R _____

2. Property Controlling in Section

S _____ T _____ R _____

S _____ T _____ R _____

3. Miscellaneous Property in Sec.

S _____ T _____ R _____

S _____ T _____ R _____

4. Lot No. _____, Recorded Plat _____
5. Private Claims _____

Kirk Breitels

in a field survey on Jan. 7 1997

do hereby state that under requirements of P.A. 74, Michigan P.A. of 1970, the corner points mentioned in lines 1 and 2 above were in conformance with regulations and rules therefore as required in the current manual of survey instructions of the United States Department of the Interior, Bureau of Land Management or by a decree of a Court of Law and/or that the corner points mentioned in lines 3, 4 and 5 above were in conformance with the rules of the Michigan Board of Land Surveyors or by a Decree of a Court of Law; established, re-established, monumented, recovered, found as expressed below:

NOTE: Not more than 2 corners, all in the same town and range, may be recorded on this certificate.

STATE OF MICHIGAN
COUNTY OF KENT
RECEIVED FOR RECORD

97 APR 29 AM 8:21

REG. OF DEEDS

W. J. [Signature]

9822

Register of Deeds Stamp & File Number

A	B	C	D	E	F	G	H	I	J	K	L	M
1												
2	6		5		4		3		2		1	
3												
4	7		8		9		10		11		12	
5												
6	18		17		16		15		14		13	
7												
8	19		20		21		22		23		24	
9												
10	30		29		28		27		26		25	
11												
12	31		32		33		34		35		36	
13												

A. Description of original monument and accessories and/or subsequent restoration:

E-7	1830	GLO	Mullett	Set Post
		Kent Co. Wit.		1" Iron "T"
	1973	LCRC #546	VanKooten	"T" Iron
	1980	LCRC #1342	Merdzinsik	"T" Iron
	1982	LCRC #3281	Hay	Set Kent County Monument
	1995	LCRC #8196	Breitels	Kent County Monument

The position of this corner was previously approved by the Kent County Remonumentation Peer Group, monumented by C. S. Hay on 3/11/82 and was recorded per LCRC #3281.

B. Description of corner evidence found and/or method applied in restoring or reestablishing corner:

E-7 Found standard Kent Co. Mon. (Harrison) per witnesses from above LCRC as set by C. S. Hay in place of the "T" Iron he found. Said "T" Iron checks with Kent Co. Wit. and LCRC's #546 & #3281.

LCRC #3281

LCRC #8196

Nail & tag 16" Oak	S20°W	56.90'	Nail & tag 30" Oak	S20°W	56.88'
Nail & tag 24" Oak	S60°W	67.98'	Nail & tag 40" Oak	S60°W	67.97'
Nail & tag 28" Maple	S45°E	56.72'	Nail & tag 48" Maple	S45°E	56.68'
Nail & tag Tw. 12" Oak	S15°W	29.79'	Nail & tag Tw. 18" Oak	S15°W	29.89'
Nail & tag 14" Hickory	N15°W	98.87'	Nail & tag 10" Poplar	N30°E	72.80'


The selected location is accepted by me and is generally accepted by professional surveyors as the best available evidence of the position of the original corner.

C. Description of monument for corner and accessories established to perpetuate locating the position of the corner:

E-7 Standard Kent County Monument

Nail & KC Remon. tag NW side 30" Oak	S20°W	56.88'
Nail & KC Remon. tag N. side 40" Oak	S60°W	67.97'
Nail & KC Remon. tag NE side 48" Maple	S55°E	56.68'
Nail & KC Remon. tag NW side 18" Oak	S15°W	29.89'
Nail & KC Remon. tag W. side 10" Poplar	N30°E	72.80'

C/L E-W road is 3' South; On C/L grav. road to North

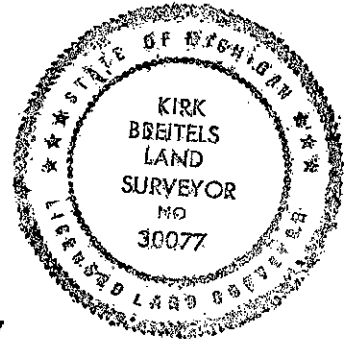

Signed by *Kirk Breitels*
Surveyor's Michigan License No. 30077

Date 3/27/97

P.A. 345 1990 KENT COUNTY

PEER APPROVED 3/27/97

CHAIRMAN *[Signature]*