

**SURVEY & REMONUMENTATION**

MAR 03 1998

KENT COUNTY REMONUMENTATION

**LAND CORNER RECORDATION CERTIFICATE**  
Filing Requirement of Act 74, Mich. P.A. 1970

SECTION

STATE OF MICHIGAN  
COUNTY OF KENT  
RECEIVED FOR RECORD  
97 APR 29 AM 8:21  
REG. OF DEEDS

For corners in

KENT COUNTY (County)	Located In:	Corner Code #
1. Public Land Survey	T 6N R 9W	E-8
	T R	
	T R	
	T R	
	T R	
2. Property Controlling in Section	S T R	
	S T R	
3. Miscellaneous Property in Sec.	S T R	
	S T R	


9823

Register of Deeds Stamp & File Number

4. Lot No. \_\_\_\_\_, Recorded Plat \_\_\_\_\_  
5. Private Claims \_\_\_\_\_

I, Kirk Breitels, in a field survey on Jan. 10, 1997 do hereby state that under requirements of P.A. 74, Michigan P.A. of 1970, the corner points mentioned in lines 1 and 2 above were in conformance with regulations and rules therefore as required in the current manual of survey instructions of the United States Department of the Interior, Bureau of Land Management or by a decree of a Court of Law and/or that the corner points mentioned in lines 3, 4 and 5 above were in conformance with the rules of the Michigan Board of Land Surveyors or by a Decree of a Court of Law; established, re-established, monumented, recovered, found as expressed below:

NOTE: Not more than 2 corners, all in the same town and range, may be recorded on this certificate.

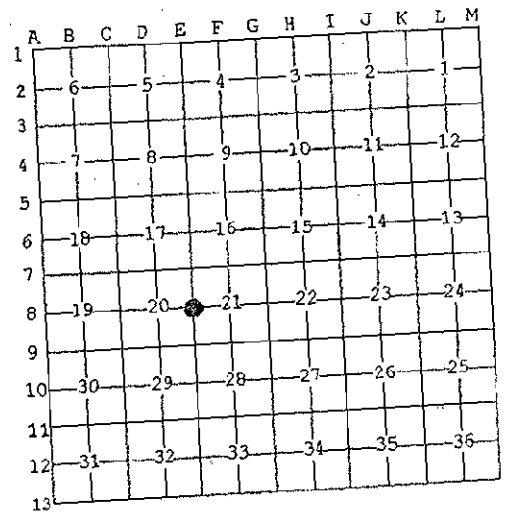

A. Description of original monument and accessories and/or subsequent restoration:

E-8	1830	GLO	Mullett	Set Post
	1965	Kent Co. Wit.		1" Iron
	1981	LCRC #2086	Nederveld	1" Iron
	1982	LCRC #3081	Merdzinski	Set Kent County Monument
	1995	LCRC #8197	Breitels	Kent County Monument

The position of this corner was previously approved by the Kent County Remonumentation Peer Group, monumented by John A. Merdzinski on 7/29/82 and was recorded per LCRC #3081

B. Description of corner evidence found and/or method applied in restoring or reestablishing corner:

E-8 Found standard Kent Co. Mon. (Harrison) per witnesses from above LCRC as set by John A. Merdzinski in place of the 1" Iron he found. Said 1" Iron checks with Kent Co. Wit. & LCRC #2086.

LCRC #3081		LCRC #8197	
Nail & tag 32" Oak	N85°W 33.05'	Nail & tag 40" Oak	N85°W 33.12'
Nail & tag 10" W. Cherry	S10°E 2.96'	Nail & tag 14" W. Cherry	S10°E 2.98'
Nail & tag 32" Oak	S20°E 44.69'	Nail & tag 42" Oak	S20°E 44.64'
Nail & tag 12" Oak	S85°E 20.37'	Nail & tag 15" Oak	S85°E 20.40'
Nail & tag 14" Oak	N30°W 61.42'	Nail & tag 20" Oak	N30°W 41.42'

The selected location is accepted by me and is generally accepted by professional surveyors as the best available evidence of the position of the original corner.

C. Description of monument for corner and accessories established to perpetuate locating the position of the corner:

E-8 Standard Kent County Monument		N85°W 33.12'
Nail & KC Remon. tag N. side 40" Oak		S10°E 2.98'
Nail & KC Remon. tag E. side 14" W. Cherry		S20°E 44.64'
Nail & KC Remon. tag W. side 42" Oak		S85°E 20.40'
Nail & KC Remon. tag N. side 15" Oak		N30°W 61.42'
Nail & KC Remon. tag E. side 20" Oak		
Corner is 13' S. of fence line running E and on fence line running W		
Remains of fence line running N-S is 20' E; C/L N-S trail is 7' W.		



Signed by Kirk Breitels  
Surveyor's Michigan License No. 30077

Date 3/27/97

P.A. 345 1990 KENT COUNTY,  
PEER APPROVED 3/27/97  
CHAIRMAN Harry H. Hesse

FORM APPROVED BY MICHIGAN STATE BOARD OF PROFESSIONAL SURVEYORS, JAN. 28, 1971  
REVISED MAY 14, 1975  
REVISED JAN. 1983  
REVISED OCT., 1995