

SURVEY & REMONUMENTATION

MAR 03 1998

KENT COUNTY REMONUMENTATION

SECTION

LAND CORNER RECORDATION CERTIFICATE
Filing Requirement of Act 74, Mich. P.A. 1970

For corners in

KENT COUNTY

(County)

Located In:

Corner Code #

1. Public Land Survey	T <u>6N</u> R <u>9W</u>	E-10
	T <u> </u> R <u> </u>	<u> </u>
	T <u> </u> R <u> </u>	<u> </u>
	T <u> </u> R <u> </u>	<u> </u>
2. Property Controlling in Section	S <u> </u> T <u> </u> R <u> </u>	<u> </u>
	S <u> </u> T <u> </u> R <u> </u>	<u> </u>
3. Miscellaneous Property in Sec.	S <u> </u> T <u> </u> R <u> </u>	<u> </u>
	S <u> </u> T <u> </u> R <u> </u>	<u> </u>

REG. OF DEEDS

Lucy Stand

97 APR 29 AM 8:22

STATE OF MICHIGAN
COUNTY OF KENT
RECEIVED FOR RECORD

9825

Register of Deeds Stamp & File Number

4. Lot No. _____, Recorded Plat _____
5. Private Claims _____

I, Kirk Breitels, in a field survey on Jan. 10, 1997 do hereby state that under requirements of P.A. 74, Michigan P.A. of 1970, the corner points mentioned in lines 1 and 2 above were in conformance with regulations and rules therefore as required in the current manual of survey instructions of the United States Department of the Interior, Bureau of Land Management or by a decree of a Court of Law and /or that the corner points mentioned in lines 3, 4 and 5 above were in conformance with the rules of the Michigan Board of Land Surveyors or by a Decree of a Court of Law, established, re-established, monumented, recovered, found as expressed below:

NOTE: Not more than 2 corners, all in the same town and range, may be recorded on this certificate.

1	A	B	C	D	E	F	G	H	I	J	K	L	M
2		6		5		4		3		2		1	
3													
4		7		8		9		10		11		12	
5													
6		18		17		16		15		14		13	
7													
8		19		20		21		22		23		24	
9													
10		30		29		28		27		26		25	
11													
12		31		32		33		34		35		36	
13													

A. Description of original monument and accessories and/or subsequent restoration:

E-10	1830	GLO	Mullett	Set Post
	1944, 1959	Kent Co. Wit.		3" Iron
	1978	LCRC #1190	Merdzinski	1" Iron
	1981	LCRC #2722	Merdzinski	Set Kent County Monument
	1995	LCRC #8199	Breitels	Kent County Monument

The position of this corner was previously approved by the Kent County Remonumentation Peer Group, monumented by John A. Merdzinski on 8/13/81 and was recorded per LCRC #2722

B. Description of corner evidence found and/or method applied in restoring or reestablishing corner:


E-10 Found standard Kent Co. Mon. (Harrison) per witnesses from above LCRC as set by John A. Merdzinski in place of the 1" Iron he found on E-W R/W fence of I-96. Said 1" Iron checks with LCRC #1190. (All 1944, 1959 Kent Co. Wit. are gone).

<u>LCRC #2722</u>		<u>LCRC #8199</u>	
Nail & tag 16" Poplar	S85°W 45.72'	Nail & tag 26" Poplar	S85°W 46.04'
Nail & tag 14" Poplar	S75°E 7.80'	Nail & tag 26" Poplar	S75°E 7.82'
Nail & tag 24" Willow	S50°E 48.75'	Nail & tag 32" Willow	S50°E 48.32'
Nail & tag 8" Poplar	S15°E 37.60'	Nail & tag 14" Poplar	S15°E 37.62'
Steel fence post	East 9.75'	Steel fence post	S90°E 9.8'

The selected location is accepted by me and is generally accepted by professional surveyors as the best available evidence of the position of the original corner.

C. Description of monument for corner and accessories established to perpetuate locating the position of the corner:

E-10 Standard Kent County Monument	
Nail & KC Remon. tag S. side 26" Poplar	S85°W 46.04'
Nail & KC Remon. tag S. side 26" Poplar	S75°E 7.82'
Nail & KC Remon. tag W. side 32" Willow	S50°E 48.32'
Nail & KC Remon. tag E. side 14" Poplar	S15°E 37.62'
Steel fence post	S90°E 9.8'
On East & West fence line (Hwy. R/W fence)	

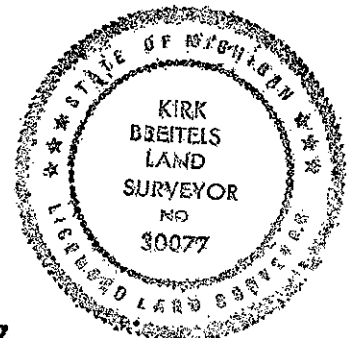

Signed by *Kirk Breitels*
Surveyor's Michigan License No. 30077

Date 3/27/97

P.A. 345 1990 KENT COUNTY
PEER APPROVED 3/27/97
CHAIRMAN *Kenneth...*