

# SURVEY & REMONUMENTATION

MAR 03 1998

KENT COUNTY REMONUMENTATION

## LAND CORNER RECORDATION CERTIFICATE

Filing Requirement of Act 74, Mich. P.A. 1970

SECTION

For corners in  
KENT COUNTY

Located In:

Corner Code #

1. Public Land Survey

	T 6N	R 9W	E-11
	T	R	_____
	T	R	_____
	T	R	_____
	T	R	_____
2. Property Controlling in Section	S	T	R
	S	T	R
3. Miscellaneous Property in Sec.	S	T	R
	S	T	R

REG. OF DEEDS

L. J. Bond

97 APR 29 AM 8:22

STATE OF MICHIGAN  
COUNTY OF KENT  
RECEIVED FOR RECORD

9826

Register of Deeds Stamp & File Number

4. Lot No. \_\_\_\_\_, Recorded Plat \_\_\_\_\_  
5. Private Claims \_\_\_\_\_

I, Kirk Breitels, in a field survey on Jan. 9, 1997 do hereby state that under requirements of P.A. 74, Michigan P.A. of 1970, the corner points mentioned in lines 1 and 2 above were in conformance with regulations and rules therefore as required in the current manual of survey instructions of the United States Department of the Interior, Bureau of Land Management or by a decree of a Court of Law and/or that the corner points mentioned in lines 3, 4 and 5 above were in conformance with the rules of the Michigan Board of Land Surveyors or by a Decree of a Court of Law; established, re-established, monumented, recovered, found as expressed below:

NOTE: Not more than 2 corners, all in the same town and range, may be recorded on this certificate.

A	B	C	D	E	F	G	H	I	J	K	L	M
1												
2	6	5	4	3	2	1						
3												
4	7	8	9	10	11	12						
5												
6	18	17	16	15	14	13						
7												
8	19	20	21	22	23	24						
9												
10	30	29	28	27	26	25						
11												
12	31	32	33	34	35	36						
13												

A. Description of original monument and accessories and/or subsequent restoration:

E-11	1830	GLO	Mullett	Set Post
	1964	Kent Co. Wit.		1" Iron
	1979	LCRC #1308	Nederveld	"T" Iron in mon. box
	1981	LCRC #2260	Merdzinski	Set Kent County Monument in mon. box
	1995	LCRC #8200	Breitels	Kent County Monument

The position of this corner was previously approved by the Kent County Remonumentation Peer Group, monumented by John A. Merzinski on 8/13/81 and was recorded per LCRC #2260


B. Description of corner evidence found and/or method applied in restoring or reestablishing corner:  
E-11 Found standard Kent Co. Mon. (Harrison) per witnesses from above LCRC as set by John A. Merdzinski in place of the "T" Iron he found inside a mon. box. Said "T" Iron checks with Kent Co. Wit. and LCRC #1308.

<u>LCRC #2260</u>	Nail/tag top g. post N75°W	100.15'	Nail/tag	<u>LCRC #8200</u>
	Nail/tag top g. post N15°W	58.48'	g. post	Nail/tag top g. post N75°W
	Nail/tag 40" Walnut S60°E	81.87'	S15°W 59.95'	Nail/tag top g. post N15°W
	Nail/tag 28" Walnut S45°E	56.83'		Nail/tag top g. post S15°W
	Nail/tag 16" Hickory N20°E	74.10'		Nail/tag 32" Walnut S45°E
				Nail/tag 24" Hickory N20°E

The selected location is accepted by me and is generally accepted by professional surveyors as the best available evidence of the position of the original corner.

C. Description of monument for corner and accessories established to perpetuate locating the position of the corner:

E-11 Standard Kent County Monument	Nail & KC Remon. tag in top end guard post	N75°W	100.20'
	Nail & KC Remon. tag in top end guard post	N15°W	59.11'
	Nail & KC Remon. tag in top end guard post	S15°W	60.17'
	Nail & KC Remon. tag SW side 32" Walnut	S45°E	56.46'
	Nail & KC Remon. tag W. side 24" Hickory	N20°E	74.08'
	C/L of "X" paved road E & W and grav. road N & S is 2' S. & 3' E.		

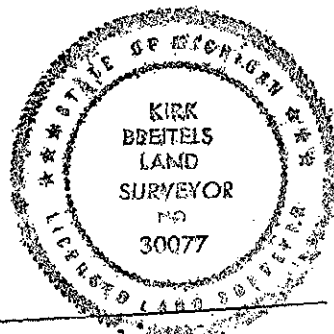

Signed by Kirk Breitels  
Surveyor's Michigan License No. 30077

Date 3/27/97

P.A. 345 1990 KENT COUNTY

PEER APPROVED 3/27/97  
CHAIRMAN Harry Hubers

FORM APPROVED BY MICHIGAN STATE BOARD OF PROFESSIONAL SURVEYORS, JAN. 28, 1971  
REVISED MAY 14, 1975  
REVISED JAN. 1983  
REVISED OCT., 1995