

**SURVEY &
REMONUMENTATION**

MAR 03 1998

KENT COUNTY REMONUMENTATION

SECTION

LAND CORNER RECORDATION CERTIFICATE
Filing Requirement of Act 74, Mich. P.A. 1970

For corners in
KENT COUNTY

(County)

Located In:

Corner Code #

1. Public Land Survey

T 6N R 9W E-13

T _____ R _____

T _____ R _____

T _____ R _____

T _____ R _____

2. Property Controlling
in Section

S _____ T _____ R _____

S _____ T _____ R _____

3. Miscellaneous
Property in Sec.

S _____ T _____ R _____

S _____ T _____ R _____

4. Lot No. _____, Recorded Plat _____
5. Private Claims _____

I, Kirk Breitels, in a field survey on Jan. 9, 1997 do hereby state that under requirements of P.A. 74, Michigan P.A. of 1970, the corner points mentioned in lines 1 and 2 above were in conformance with regulations and rules therefore as required in the current manual of survey instructions of the United States Department of the Interior, Bureau of Land Management or by a decree of a Court of Law and/or that the corner points mentioned in lines 3, 4 and 5 above were in conformance with the rules of the Michigan Board of Land Surveyors or by a Decree of a Court of Law; established, re-established, monumented, recovered, found as expressed below:

NOTE: Not more than 2 corners, all in the same town and range, may be recorded on this certificate.

STATE OF MICHIGAN
COUNTY OF KENT
RECEIVED FOR RECORD

97 APR 29 AM 8:22

REG. OF DEEDS

9827

Register of Deeds Stamp & File Number

	A	B	C	D	E	F	G	H	I	J	K	L	M
1													
2	6		5		4		3		2		1		
3													
4	7		8		9		10		11		12		
5													
6	18		17		16		15		14		13		
7													
8	19		20		21		22		23		24		
9													
10	30		29		28		27		26		25		
11													
12	31		32		33		34		35		36		
13													

A. Description of original monument and accessories and/or subsequent restoration:

E-13	1830	GLO	Mullett	Set Post
		Kent Co. Wit.		Spike
	1983	LCRC #3661	Bonnema	PK Nail
	1986	LCRC #4424	Jonker	Set Kent County Monument
	1995	LCRC #8202	Breitels	Kent County Monument

The position of this corner was previously approved by the Kent County Remonumentation Peer Group, monumented by Robert J. Jonker on 2/2/84 and was recorded per LCRC #4424

B. Description of corner evidence found and/or method applied in restoring or reestablishing corner:

E-13 Found standard Kent Co. Mon. (Harrison) per witnesses from above LCRC as set by Robert J. Jonker in place of the PK Nail he found. Said PK Nail checks with Kent Co. Wit. & LCRC #3661.

LCRC #4424

C/L RR tracks (Rt. angle) SW'ly 14.9'
Remon. tag Tel. Pole N20°W 43.10'
Remon. tag P. Pole N35°E 55.67'
C/L S. anchor bolt RR sign S70°W 41.15'
Kent Co. Mon. East 68.6'


LCRC #8202 KC Mon. (E-1, 5-9) E. 68.60'
C/L RR tracks (Rt. angle) S30°W 14.90'
Nail & tag Tel. Pole N20°W 42.83'
Nail & tag P. Pole N35°E 55.73'
C/L S. anchor bolt RR sign S70°W 41.10'
C/L NW anchor bolt RR sign S90°E 49.10'

The selected location is accepted by me and is generally accepted by professional surveyors as the best available evidence of the position of the original corner.

C. Description of monument for corner and accessories established to perpetuate locating the position of the corner:

E-13 Standard Kent County Monument

C/L RR tracks (Rt. angle)	S30°W	14.90'
Nail & KC Remon. tag E. side Tel. Pole	N20°W	42.83'
Nail & KC Remon. tag E. side P. Pole	N35°E	55.73'
C/L S. anchor bolt to base RR sign	S70°W	41.10'
C/L NW anchor bolt to base RR sign	S30°E	49.10'
Kent Co. Mon. (E-1, T5N, R9W)	S90°E	68.60'

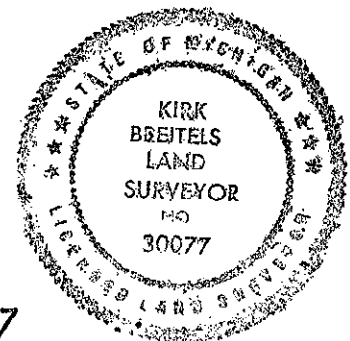

Signed by Kirk Breitels

Date 3/27/97

Surveyor's Michigan License No. _____

P.A. 345 1990 KENT COUNTY

PEER APPROVED 3/27/97

CHAIRMAN Harry Huber