

**SURVEY & REMONUMENTATION**

MAR 03 1998

KENT COUNTY REMONUMENTATION

SECTION

LAND CORNER RECORDATION CERTIFICATE  
Filing Requirement of Act 74, Mich. P.A. 1970

For corners in

KENT COUNTY

(County)

Located In:

Corner Code #

1. Public Land Survey

T6N R9W F-1

T R  
T R  
T R

2. Property Controlling in Section

S T R  
S T R

3. Miscellaneous Property in Sec.

S T R  
S T R

STATE OF MICHIGAN  
COUNTY OF KENT  
RECEIVED FOR RECORD  
97 APR 29 AM 8:22  
REG. OF DEEDS  
*Lucas St. Paul*

9828

Register of Deeds Stamp & File Number

4. Lot No. \_\_\_\_\_, Recorded Plat \_\_\_\_\_  
5. Private Claims \_\_\_\_\_

I, Kirk Breitels, in a field survey on Jan. 6, 1997 do hereby state that under requirements of P.A. 74, Michigan P.A. of 1970, the corner points mentioned in lines 1 and 2 above were in conformance with regulations and rules therefore as required in the current manual of survey instructions of the United States Department of the Interior, Bureau of Land Management or by a decree of a Court of Law and /or that the corner points mentioned in lines 3, 4 and 5 above were in conformance with the rules of the Michigan Board of Land Surveyors or by a Decree of a Court of Law; established, re-established, monumented, recovered, found as expressed below:

NOTE: Not more than 2 corners, all in the same town and range, may be recorded on this certificate.

1	A	B	C	D	E	F	G	H	I	J	K	L	M
2		6		5		4		3		2		1	
3													
4		7		8		9		10		11		12	
5													
6		18		17		16		15		14		13	
7													
8		19		20		21		22		23		24	
9													
10		30		29		28		27		26		25	
11													
12		31		32		33		34		35		36	
13													

A. Description of original monument and accessories and/or subsequent restoration:

F-1	1830	GLO	Mullett	Not Set
		Kent Co. Wit.		Iron
	1954-75	Williams & Works		Iron - 71.40' W. of F-13, T7N, R9W
	1976	LCRC #988	Nederveld	Round Iron
	1985	LCRC #4146	Rosema	Set Kent County Monument
	1991	LCRC #5836	Unema	Kent County Monument

The position of this corner was previously approved by the Kent County Remonumentation Peer Group, monumented by Maurice J. Rosema on 3/7/85 and was recorded per LCRC #4146

B. Description of corner evidence found and/or method applied in restoring or reestablishing corner:


F-1 Found standard Kent Co. Mon. (Harrison) per witnesses from above LCRC as set by Maurice J. Rosema on Twp. line in place of the 3/4" Iron Pipe he found. Said Iron Pipe checks with Kent Co. Wit., Williams & Works information and LCRC #988.

<u>LCRC #4146</u>		<u>LCRC #5836</u>
Nail & tag 30" Oak	N25°W 31.23'	Nail & tag 32" Oak N25°W 31.23'
Nail & tag 15" Poplar	N34°E 33.98'	Nail & tag 36" Spruce S03°W 35.48'
Nail & tag 24" Pine	S03°W 35.50'	Nail & tag 32" Oak S66°W 63.05'
Nail & tag 30" Oak	S66°W 63.10'	Nail & tag 16" Poplar N34°E 33.98'
KC Mon. (F-13, 7-9)	East 71.41'	KC Mon. (F-13, 7-9) East 71.41'

The selected location is accepted by me and is generally accepted by professional surveyors as the best available evidence of the position of the corner.

C. Description of monument for corner and accessories established to perpetuate locating the position of the corner:

F-1	Standard Kent County Monument
Nail & KC Remon. tag NE side	36" Oak N25°W 31.23'
Nail & KC Remon. tag E. side	36" Spruce S03°W 35.51'
Nail & KC Remon. tag NW side	34" Oak S66°W 63.05'
Nail & KC Remon. tag E. side	18" Poplar N34°E 33.98'
Kent Co. Mon. (F-13, T7N, R9W)	East 71.41'

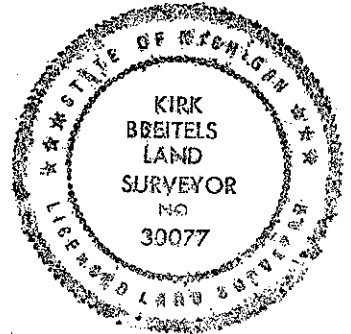

Signed by *Kirk Breitels*  
Surveyor's Michigan License No. 30077

Date 3/27/97

P.A. 345 1990 KENT COUNTY  
PEER APPROVED 3/27/97  
CHAIRMAN *Harry Hubers* FORM APPROVED BY MICHIGAN STATE BOARD OF PROFESSIONAL SURVEYORS, JAN. 28, 1971  
REVISED MAY 14, 1975  
REVISED JAN, 1983  
REVISED OCT., 1995