

**SURVEY & REMONUMENTATION**

MAR 03 1998

**SECTION**

**KENT COUNTY REMONUMENTATION**

**LAND CORNER RECORDATION CERTIFICATE**  
Filing Requirement of Act 74, Mich. P.A. 1970

For corners in

KENT COUNTY

(County)

Located In:

Corner Code #

1. Public Land Survey

T 6N R 9W

F-2

T \_\_\_\_\_ R \_\_\_\_\_  
T \_\_\_\_\_ R \_\_\_\_\_  
T \_\_\_\_\_ R \_\_\_\_\_  
T \_\_\_\_\_ R \_\_\_\_\_

2. Property Controlling in Section

S \_\_\_\_\_ T \_\_\_\_\_ R \_\_\_\_\_  
S \_\_\_\_\_ T \_\_\_\_\_ R \_\_\_\_\_  
S \_\_\_\_\_ T \_\_\_\_\_ R \_\_\_\_\_  
S \_\_\_\_\_ T \_\_\_\_\_ R \_\_\_\_\_

3. Miscellaneous Property in Sec.

4. Lot No. \_\_\_\_\_, Recorded Plat \_\_\_\_\_  
5. Private Claims \_\_\_\_\_

I, Kirk Breitels, in a field survey on June 17, 1997 do hereby state that under requirements of P.A. 74, Michigan P.A. of 1970, the corner points mentioned in lines 1 and 2 above were in conformance with regulations and rules therefore as required in the current manual of survey instructions of the United States Department of the Interior, Bureau of Land Management or by a decree of a Court of Law and/or that the corner points mentioned in lines 3, 4 and 5 above were in conformance with the rules of the Michigan Board of Land Surveyors or by a Decree of a Court of Law; established, re-established, monumented, recovered, found as expressed below:

NOTE: Not more than 2 corners, all in the same town and range, may be recorded on this certificate.

A. Description of original monument and accessories and/or subsequent restoration:

F-2 1830---GLO---Not Set  
1919---Williams & Works---Survey in SE 1/4 - no desc. of C 1/4 cor.  
1939-75---Williams & Works---Set/Used Iron - retraced 1919 survey  
10" Oak SE 5.6' 8" Oak E 5.9' 16" dbl. Oak NE 9.8'  
1974---LCRC #646---VanKooten---3/4" Iron at fence corner  
10" Oak E 6.15' 14" Oak SSE 5.91' Tw. 36" Oak NNE 10.77'

B. Description of corner evidence found and/or method applied in restoring or reestablishing corner:

F-2 Found 3/4" Iron Pipe at fence corner per the remaining witnesses:  
C/L 18" Oak SSE 6'±  
C/L Tw. 36" Oak NNE 11'±

3/4" Iron Pipe is 3.6' S. and 0.8' W. from intersection of 1/4 lines and agrees with measurements of others.

The 3/4" Iron Pipe is accepted by me and is generally accepted by professional surveyors as the best available evidence of the position of the corner.

C. Description of monument for corner and accessories established to perpetuate locating the position of the corner:

F-2 Set Standard Kent Co. Monument (Harrison) in place of the 3/4" Iron Pipe  
Nail & KC Remon. tag SW side 18" Oak S15°E 6.15'  
Nail & KC Remon. tag SE side Tw. 36" Oak N40°E 10.88'  
Nail & KC Remon. tag S. side 8" Oak N70°W 3.31'  
Nail & KC Remon. tag N. side Tw. 24" Oak S90°E 32.41'  
Nail & KC Remon. tag SW side 24" Oak N50°W 39.17'

REG. OF DEEDS  
97 OCT 14 AM 10:00  
STATE OF MICHIGAN  
COUNTY OF KENT  
RECEIVED FOR RECORD


10037

Register of Deeds Stamp & File Number

A	B	C	D	E	F	G	H	I	J	K	L	M
1												
2	6		5		4		3		2		1	
3												
4	7		8		9		10		11		12	
5												
6	18		17		16		15		14		13	
7												
8	19		20		21		22		23		24	
9												
10	30		29		28		27		26		25	
11												
12	31		32		33		34		35		36	
13												

Signed by Kirk Breitels  
Surveyor's Michigan License No. 30077

Date 8/28/97

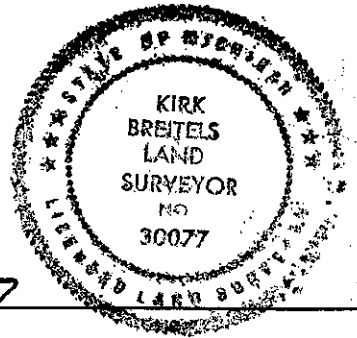

P.A. 345 1990 KENT COUNTY  
PEER APPROVED 7/24/97  
CHAIRMAN Harry Hubbell