

SURVEY & REMONUMENTATION

MAR 03 1998


KENT COUNTY REMONUMENTATION

SECTION

LAND CORNER RECORDATION CERTIFICATE
Filing Requirement of Act 74, Mich. P.A. 1970

For corners in

KENT COUNTY (County)	Located In:	Corner Code #
1. Public Land Survey	T <u>6N</u> R <u>9W</u>	<u>F-3</u>
	T <u> </u> R <u> </u>	<u> </u>
	T <u> </u> R <u> </u>	<u> </u>
	T <u> </u> R <u> </u>	<u> </u>
2. Property Controlling in Section	S <u> </u> T <u> </u> R <u> </u>	<u> </u>
	S <u> </u> T <u> </u> R <u> </u>	<u> </u>
3. Miscellaneous Property in Sec.	S <u> </u> T <u> </u> R <u> </u>	<u> </u>
	S <u> </u> T <u> </u> R <u> </u>	<u> </u>

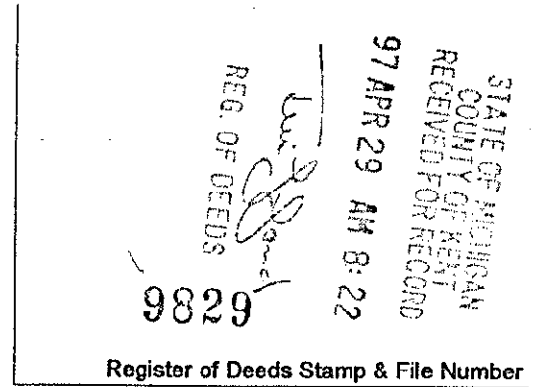

4. Lot No. _____, Recorded Plat _____
5. Private Claims _____

I, Kirk Breitels, in a field survey on Jan. 10, 1997 do hereby state that under requirements of P.A. 74, Michigan P.A. of 1970, the corner points mentioned in lines 1 and 2 above were in conformance with regulations and rules therefore as required in the current manual of survey instructions of the United States Department of the Interior, Bureau of Land Management or by a decree of a Court of Law and /or that the corner points mentioned in lines 3, 4 and 5 above were in conformance with the rules of the Michigan Board of Land Surveyors or by a Decree of a Court of Law; established, re-established, monumented, recovered, found as expressed below:

NOTE: Not more than 2 corners, all in the same town and range, may be recorded on this certificate.

	A	B	C	D	E	F	G	H	I	J	K	L	M
1													
2	6	5	4	3	2	1							
3													
4	7	8	9	10	11	12							
5													
6	18	17	16	15	14	13							
7													
8	19	20	21	22	23	24							
9													
10	30	29	28	27	26	25							
11													
12	31	32	33	34	35	36							
13													

A. Description of original monument and accessories and/or subsequent restoration:

F-3	1830	GLO	Mullett	Set Post
		Kent Co. Wit.		Leaded Stone
	1974	LCRC #646	VanKooten	Leaded Stone
	1981	LCRC #2723	Merdzinski	Set Kent County Monument
	1995	LCRC #8203	Breitels	Kent County Monument

The position of this corner was previously approved by the Kent County Remonumentation Peer Group, monumented by John A. Merdzinski on 12/30/81 and was recorded per LCRC #2723

B. Description of corner evidence found and/or method applied in restoring or reestablishing corner:

F-3 Found standard Kent Co. Mon. (Harrison) per witnesses from above LCRC as set by John A. Merdzinski in place of the Leaded Stone he found. Said Leaded Stone checks with Kent Co. Wit. & LCRC #646.

LCRC #2723

Nail & tag 16" Ash	N60°W	22.31'	SE cor.
Nail & tag 16" Ash	N10°W	40.12'	bldg.
Nail & tag 40" Oak	N35°E	100.85'	N45°W
Nail & tag 10" Ash	N85°E	35.53'	54.10'
Nail & tag 4" Birch	S20°W	9.78'	

LCRC #8203

Nail & tag 22" Ash	N60°W	22.28'
Nail & tag 24" Ash	N10°W	40.15'
Nail & tag 20" Ash	N85°E	35.56'
Nail & tag 10" Birch	S20°W	9.92'
SE cor. conc. blk. bldg.	N45°W	54.10'

The selected location is accepted by me and is generally accepted by professional surveyors as the best available evidence of the position of the original corner.

C. Description of monument for corner and accessories established to perpetuate locating the position of the corner:

F-3 Standard Kent County Monument

Nail & KC Remon. tag N. side 22" Ash	N60°W	22.28'
Nail & KC Remon. tag E. side 24" Ash	N10°W	40.15'
Nail & KC Remon. tag N. side 20" Ash	N85°E	35.56'
Nail & KC Remon. tag NW side 10" Birch	S20°W	9.92'
SE corner conc. block bldg. (Bowling Alley)	N45°W	54.10'



Signed by Kirk Breitels
Surveyor's Michigan License No. 30077

Date 3/27/97

P.A. 345 1990 KENT COUNTY

PEER APPROVED 3/27/97

CHAIRMAN [Signature]