

MAR 03 1998

SECTION

KENT COUNTY REMONUMENTATION

LAND CORNER RECORDATION CERTIFICATE
Filing Requirement of Act 74, Mich. P.A. 1970

For corners in

KENT COUNTY
(County)

Located In:

Corner Code #

- 1. Public Land Survey T 6N R 9W F-7
- T R _____
- T R _____
- T R _____
- T R _____
- 2. Property Controlling S T R _____
- In Section S T R _____
- 3. Miscellaneous S T R _____
- Property in Sec. S T R _____

STATE OF MICHIGAN
 COUNTY OF KENT
 RECEIVED FOR RECORD
 97 APR 29 AM 8:22
 REG. OF DEEDS
Luc: [Signature]


9831

Register of Deeds Stamp & File Number

- 4. Lot No. _____, Recorded Plat _____
- 5. Private Claims _____

I, Kirk Breitels, in a field survey on Jan. 7 1997 do hereby state that under requirements of P.A. 74, Michigan P.A. of 1970, the corner points mentioned in lines 1 and 2 above were in conformance with regulations and rules therefore as required in the current manual of survey instructions of the United States Department of the Interior, Bureau of Land Management or by a decree of a Court of Law and/or that the corner points mentioned in lines 3, 4 and 5 above were in conformance with the rules of the Michigan Board of Land Surveyors or by a Decree of a Court of Law; established, re-established, monumented, recovered, found as expressed below:

NOTE: Not more than 2 corners, all in the same town and range, may be recorded on this certificate.

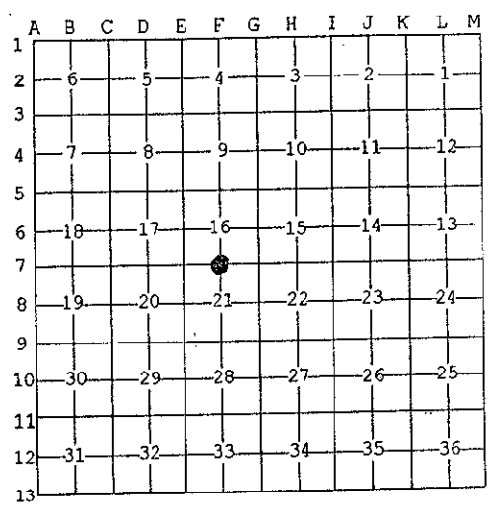

A. Description of original monument and accessories and/or subsequent restoration:

F-7	1830	GLO	Mullett	Set Post
		Kent Co. Wit.		1" Iron over stone
1973		LCRC #602	VanKooten	1" Round Iron
1982		LCRC #3287	Hay	Set Kent County Monument
1995		LCRC #8205	Breitels	Kent County Monument

The position of this corner was previously approved by the Kent County Remonumentation Peer Group, monumented by C. S. Hay on 3/11/82 and was recorded per LCRC #3287

B. Description of corner evidence found and/or method applied in restoring or reestablishing corner:

F-7 Found standard Kent Co. Mon. (Harrison) per witnesses from above LCRC as set by C. S. Hay in place of the 1" Round Iron, 1 1/4" Iron 12" down, 1/2" Boat Spike 12" down he found all over a large stone. Irons and stone check with Kent Co. Wit. & LCRC #602.

LCRC #3287				LCRC #8205			
Nail & tag 10" Pin Oak	N45°W	66.90'		Nail & tag 18" Pin Oak	N45°W	66.90'	
Nail & tag 16" Oak	N40°E	36.53'		Nail & tag 33" Oak	N15°E	68.12'	
Nail & tag 30" Oak	N15°E	68.12'		Nail & tag 20" Tw. Oak	S45°E	61.06'	
Nail & tag 16" Tw. Oak	S45°E	61.06'		Nail & tag 18" Oak	S30°E	74.32'	
Nail & tag 14" Oak	S30°E	74.32'					

The selected location is accepted by me and is generally accepted by professional surveyors as the best available evidence of the position of the original corner.

C. Description of monument for corner and accessories established to perpetuate locating the position of the corner:

F-7 Standard Kent County Monument

Nail & KC Remon. tag NE side 18" Pin Oak	N45°W	66.90'
Nail & KC Remon. tag SE side 36" Oak	N15°E	68.12'
Nail & KC Remon. tag NE side 20" Tw. Oak	S45°E	61.06'
Nail & KC Remon. tag W. side 18" Oak	S30°E	74.32'



Signed by Kirk Breitels
 Surveyor's Michigan License No. 30077

Date 3/27/97

P.A. 345 1990 KENT COUNTY
 PEER APPROVED 3/27/97
 CHAIRMAN [Signature]