

SURVEY & REMONUMENTATION

MAR 03 1998

KENT COUNTY REMONUMENTATION

SECTION

LAND CORNER RECORDATION CERTIFICATE
Filing Requirement of Act 74, Mich. P.A. 1970

For corners in

KENT COUNTY (County)	Located In:	Corner Code #
1. Public Land Survey	T <u>6N</u> R <u>9W</u>	<u>F-9</u>
	T <u> </u> R <u> </u>	<u> </u>
	T <u> </u> R <u> </u>	<u> </u>
	T <u> </u> R <u> </u>	<u> </u>
2. Property Controlling in Section	S <u> </u> T <u> </u> R <u> </u>	<u> </u>
	S <u> </u> T <u> </u> R <u> </u>	<u> </u>
3. Miscellaneous Property in Sec.	S <u> </u> T <u> </u> R <u> </u>	<u> </u>
	S <u> </u> T <u> </u> R <u> </u>	<u> </u>

STATE OF MICHIGAN
COUNTY OF KENT
RECEIVED FOR RECORD
97 APR 29 AM 8:22
REG. OF DEEDS
Lucy Stand

9832

Register of Deeds Stamp & File Number

4. Lot No. _____, Recorded Plat _____
5. Private Claims _____

I, Kirk Breitels, in a field survey on Jan. 10 19 97 do hereby state that under requirements of P.A. 74, Michigan P.A. of 1970, the corner points mentioned in lines 1 and 2 above were in conformance with regulations and rules therefore as required in the current manual of survey instructions of the United States Department of the Interior, Bureau of Land Management or by a decree of a Court of Law and /or that the corner points mentioned in lines 3, 4 and 5 above were in conformance with the rules of the Michigan Board of Land Surveyors or by a Decree of a Court of Law; established, re-established, monumented, recovered, found as expressed below:

NOTE: Not more than 2 corners, all in the same town and range, may be recorded on this certificate.

1	A	B	C	D	E	F	G	H	I	J	K	L	M
2		6		5		4		3		2		1	
3													
4		7		8		9		10		11		12	
5													
6		18		17		16		15		14		13	
7													
8		19		20		21		22		23		24	
9													
10		30		29		28		27		26		25	
11													
12		31		32		33		34		35		36	
13													

A. Description of original monument and accessories and/or subsequent restoration:

F-9	1830	GLO	Mullett	Set Post
	1963	Kent Co. Wit.		PK Nail & "X" cut
	1981	LCRC #2086	Nederveld	PK Nail
	1982	LCRC #3101	Merdzinski	Set Kent County Monument
	1995	LCRC #8206	Breitels	Kent County Monument

The position of this corner was previously approved by the Kent County Remonumentation Peer Group, monumented by John A. Merdziski on 10/14/82 and was recorded per LCRC #3101

B. Description of corner evidence found and/or method applied in restoring or reestablishing corner:


F-9 Found standard Kent Co. Mon. (Harrison) per witnesses from above LCRC as set by John A. Merdzinski in place of the PK Nail he found. Said PK Nail checks with Kent Co. Wit. & LCRC #2086.

LCRC #3101				LCRC #8206			
Nail & tag 12" Oak	S60°W	50.90'		Nail & tag 18" Oak	S60°W	50.86'	
Nail & tag 24" Oak	S30°W	29.16'		Nail & tag 30" Oak	S30°W	29.21'	
Nail & tag 12" Ash	S45°E	45.31'		Nail & tag 18" Ash	S45°E	45.45'	
Nail & tag Tri. 6" Ash	N50°E	43.30'		Nail & tag Tri. 10" Ash	N50°E	43.20'	
Nail & tag 8" Elm	N50°W	39.62'		Nail & tag 15" Elm	N50°W	39.69'	

The selected location is accepted by me and is generally accepted by professional surveyors as the best available evidence of the position of the original corner.

C. Description of monument for corner and accessories established to perpetuate locating the position of the corner:

F-9 Standard Kent County Monument			
Nail & KC Remon. tag SE side 18" Oak	S60°W	50.86'	
Nail & KC Remon. tag W. side 30" Oak	S30°W	29.21'	
Nail & KC Remon. tag NE side 18" Ash	S45°E	45.45'	
Nail & KC Remon. tag E. side Tri. 10" Ash	N50°E	43.20'	
Nail & KC Remon. tag SW side 15" Elm	N50°W	39.69'	
Corner is in centerline Cascade Road running E & W			

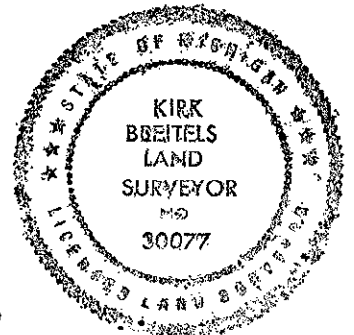

Signed by *Kirk Breitels*
Surveyor's Michigan License No. 30077

Date 3/27/97

P.A. 345 1990 KENT COUNTY
PEER APPROVED 3/27/97
CHAIRMAN *Harry Hubert*