

SURVEY & REMONUMENTATION

MAR 03 1998

KENT COUNTY REMONUMENTATION

LAND CORNER RECORDATION CERTIFICATE Filing Requirement of Act 74, Mich. P.A. 1970

SECTION

For corners in

KENT COUNTY
(County)

Located In:

Corner Code #

- | | | |
|------------------------------------|-------------------------|-------------|
| 1. Public Land Survey | T <u>6N</u> R <u>9W</u> | <u>F-13</u> |
| | T _____ R _____ | _____ |
| | T _____ R _____ | _____ |
| | T _____ R _____ | _____ |
| 2. Property Controlling in Section | S _____ T _____ R _____ | _____ |
| | S _____ T _____ R _____ | _____ |
| 3. Miscellaneous Property in Sec. | S _____ T _____ R _____ | _____ |

STATE OF MICHIGAN
 COUNTY OF KENT
 RECEIVED FOR RECORD
 97 APR 29 AM 8:22
 REG. OF DEEDS
Lucy Bond

9834

Register of Deeds Stamp & File Number

4. Lot No. _____, Recorded Plat _____
 5. Private Claims _____

I, Kirk Breitels, in a field survey on Jan. 23, 1997 do hereby state that under requirements of P.A. 74, Michigan P.A. of 1970, the corner points mentioned in lines 1 and 2 above were in conformance with regulations and rules therefore as required in the current manual of survey instructions of the United States Department of the Interior, Bureau of Land Management or by a decree of a Court of Law and /or that the corner points mentioned in lines 3, 4 and 5 above were in conformance with the rules of the Michigan Board of Land Surveyors or by a Decree of a Court of Law; established, re-established, monumented, recovered, found as expressed below:

NOTE: Not more than 2 corners, all in the same town and range, may be recorded on this certificate.

1	A	B	C	D	E	F	G	H	I	J	K	L	M
2		6		5		4		3		2		1	
3													
4		7		8		9		10		11		12	
5													
6		10		17		16		15		14		13	
7													
8		19		20		21		22		23		24	
9													
10		30		29		28		27		26		25	
11													
12		31		32		33		34		35		36	
13													

A. Description of original monument and accessories and/or subsequent restoration:

F-13	1830	GLO	Mullett	Set Post
	1933	Kent Co. Wit.		Iron & Stone
	1973	LCRC #942	Spicer	3/4" Iron
	1981	LCRC #1698	Merszinski	Set Kent County Monument
	1995	LCRC #8208	Breitels	Kent County Monument

The position of this corner was previously approved by the Kent County Remonumentation Peer Group, monumented by John A. Merdzinski on 2/24/81 and was recorded per LCRC #1698

B. Description of corner evidence found and/or method applied in restoring or reestablishing corner:


F-13 Found standard Kent Co. Mon. (Harrison) per witnesses from above LCRC as set by John A. Merdzinski in place of the 1" Solid Iron & PK Nail he found. Said Iron and PK Nail check with Kent Co. Wit. & LCRC #942.

<u>LCRC #1698</u>	NE cor. Church Fnd.	S10°W	86.20'	
	SE cor. Hse. Fnd.	N30°W	74.73'	Nail & tag
	Nail & tag 40" Oak	S50°W	50.27'	40" Oak
	Nail & tag Elec. Cont. Box	N	51.17'	S50°E 60.18'
	Nail & tag P. Pole	N70°E	80.89'	
<u>LCRC #8208</u>				same witnesses as LCRC #1698

The selected location is accepted by me and is generally accepted by professional surveyors as the best available evidence of the position of the original corner.

C. Description of monument for corner and accessories established to perpetuate locating the position of the corner:

F-13 Standard Kent County Monument		S10°W	86.16'
NE cor. Church Fnd.		N30°W	74.68'
SE cor. Hse. Fnd.		S50°W	50.27'
Nail & KC Remon. tag W. side 48" Oak		N00°E	51.10'
Nail & KC Remon. tag W. side Elec. Cont. Box Pole		N70°E	80.77'
Nail & KC Remon. tag N. side P. Pole		S50°E	60.20'
Nail & KC Remon. tag N. side 48" Oak			
In C/L road E & W and on C/L road N			
C/L road S is 68' East			

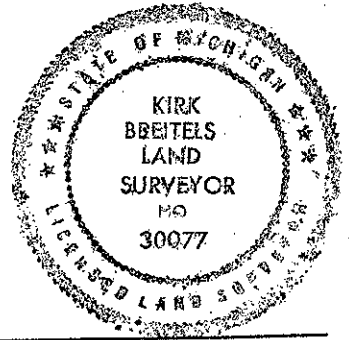

Signed by Kirk Breitels
 Surveyor's Michigan License No. 30077

Date 3/27/97

P.A. 345 1990 KENT COUNTY
 PEER APPROVED 3/27/97
 CHAIRMAN [Signature]