

SURVEY & REMONUMENTATION

MAR 03 1998

KENT COUNTY REMONUMENTATION

SECTION

LAND CORNER RECORDATION CERTIFICATE Filing Requirement of Act 74, Mich. P.A. 1970

For corners in


KENT COUNTY

(County)

Located In:

Corner Code #

1. Public Land Survey	T <u>6</u> N	R <u>9</u> W	G-1
	T <u> </u>	R <u> </u>	<u> </u>
	T <u> </u>	R <u> </u>	<u> </u>
	T <u> </u>	R <u> </u>	<u> </u>
2. Property Controlling in Section	S <u> </u>	T <u> </u>	R <u> </u>
	S <u> </u>	T <u> </u>	R <u> </u>
3. Miscellaneous Property in Sec.	S <u> </u>	T <u> </u>	R <u> </u>
	S <u> </u>	T <u> </u>	R <u> </u>

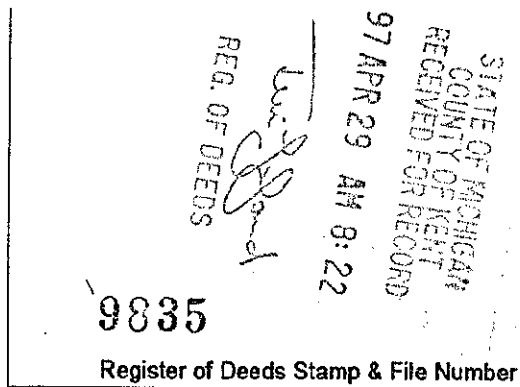

4. Lot No. _____, Recorded Plat _____
5. Private Claims _____

I, Kirk Breitels, in a field survey on Jan. 6, 1997 do hereby state that under requirements of P.A. 74, Michigan P.A. of 1970, the corner points mentioned in lines 1 and 2 above were in conformance with regulations and rules therefore as required in the current manual of survey instructions of the United States Department of the Interior, Bureau of Land Management or by a decree of a Court of Law and for that the corner points mentioned in lines 3, 4 and 5 above were in conformance with the rules of the Michigan Board of Land Surveyors or by a Decree of a Court of Law; established, re-established, monumented, recovered, found as expressed below:

NOTE: Not more than 2 corners, all in the same town and range, may be recorded on this certificate.

	A	B	C	D	E	F	G	H	I	J	K	L	M
1													
2	6	5	4	3	2	1							
3													
4	7	8	9	10	11	12							
5													
6	18	17	16	15	14	13							
7													
8	19	20	21	22	23	24							
9													
10	30	29	28	27	26	25							
11													
12	31	32	33	34	35	36							
13													

A. Description of original monument and accessories and/or subsequent restoration:

G-1	1830	GLO	Mullett	Set Post
	1963	Kent Co. Wit.		3/4" Iron on Leaded Stone
	1975	Williams & Works		3/4" Iron 1.4' N. of twp. line
	1976	LCRC #988	Nederveld	Round Iron
	1985	LCRC #4160	Rosema	Set Kent County Monument
	1991	LCRC #5797	Unema	Kent County Monument

The position of this corner was previously approved by the Kent County Remonumentation Peer Group, monumented by Maurice J. Rosema on 4/1/85 and was recorded per LCRC #4160

B. Description of corner evidence found and/or method applied in restoring or reestablishing corner:

G-1 Found standard Kent Co. Mon. (Harrison) per witnesses from above LCRC as set by Maurice J. Rosema on Twp. Line. Found 1/2" Iron in Mon. Box 1.53' N. of Twp. Line that checks with Kent Co. Wit., Williams & Works information and LCRC #988.

LCRC #4160

LCRC #5797


Nail & tag P. Pole	S24°W 101.74'	PK Nail & tag in curb joint	N28°E 36.40'
PK Nail & tag curb joint	N25°E 36.40'	Nail & tag P. Pole	S24°W 101.74'
"X" top of 24" Culv.	S47°W 44.66'	"X" top of 24" Culv.	S48°W 44.68'
"X" top of 24" Culv.	N39°W 43.24'	"X" top of 24" Culv.	N38°W 43.24'
KC Mon. (G-13, 7-9)	East 90.00'	KC Mon. (G-13, 7-9)	East 90.00'

The selected location is accepted by me and is generally accepted by professional surveyors as the best available evidence of the position of the original corner.

C. Description of monument for corner and accessories established to perpetuate locating the position of the corner:

G-1 Standard Kent County Monument

Nail & KC Remon. tag NW side	P. Pole	S24°W	101.81'
"X" in top of 24" Conc. Culv.		S48°W	44.75'
"X" in top of 24" Conc. Culv.		N38°W	43.24'
Nail & KC Remon. tag W. side	Guy Pole	S00°E	33.92'
Kent Co. Mon. (G-13, T7N, R9W)		East	89.98'
Mon. is on C/L E-W BT road & 45'± W. of C/L BT N-S road			

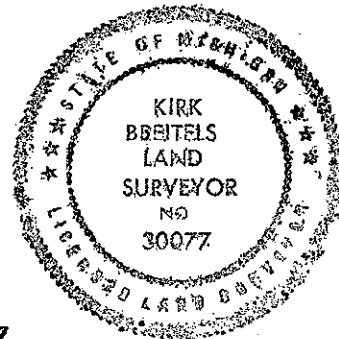

Signed by Kirk Breitels

Date 3/27/97

Surveyor's Michigan License No. 30077

P.A. 345 1990 KENT COUNTY

PEER APPROVED 3/27/97

CHAIRMAN Harry Hubert

FORM APPROVED BY MICHIGAN STATE BOARD OF PROFESSIONAL SURVEYORS, JAN. 28, 1971

REVISED MAY 14, 1975

REVISED JAN., 1983

REVISED OCT., 1985