

**SURVEY & REMONUMENTATION**

MAR 03 1998

KENT COUNTY REMONUMENTATION

**SECTION**

**LAND CORNER RECORDATION CERTIFICATE**  
Filing Requirement of Act 74, Mich. P.A. 1970

For corners in  
KENT COUNTY  
(County)

Located In:	Corner Code #
T 6N R 9W	G-4
T R	
T R	
T R	
T R	
S T R	
S T R	
S T R	
S T R	

- Public Land Survey
- Property Controlling in Section
- Miscellaneous Property in Sec.

REG. OF DEEDS  
97 APR 29 AM 8:22  
STATE OF MICHIGAN  
COUNTY OF KENT  
RECEIVED FOR RECORD

9838

Register of Deeds Stamp & File Number

- Lot No. \_\_\_\_\_, Recorded Plat \_\_\_\_\_
- Private Claims \_\_\_\_\_

I, Kirk Breitels, in a field survey on Jan. 30, 1997 do hereby state that under requirements of P.A. 74, Michigan P.A. of 1970, the corner points mentioned in lines 1 and 2 above were in conformance with regulations and rules therefore as required in the current manual of survey instructions of the United States Department of the Interior, Bureau of Land Management or by a decree of a Court of Law and /or that the corner points mentioned in lines 3, 4 and 5 above were in conformance with the rules of the Michigan Board of Land Surveyors or by a Decree of a Court of Law; established, re-established, monumented, recovered, found as expressed below:

NOTE: Not more than 2 corners, all in the same town and range, may be recorded on this certificate.

	A	B	C	D	E	F	G	H	I	J	K	L	M
1													
2	6	5	4	3	2	1							
3													
4	7	8	9	10	11	12							
5													
6	18	17	16	15	14	13							
7													
8	19	20	21	22	23	24							
9													
10	30	29	28	27	26	25							
11													
12	31	32	33	34	35	36							
13													

A. Description of original monument and accessories and/or subsequent restoration:

Date	Surveyor	Monument	Accessories
G-4 1830	GLO	Mullett	Set Post Stone
1968	Williams & Works		2" dia. 4' high Iron Pipe
1980	Exxel Engineering		Split Stone - Set Capped Re-rod
1984	LCRC #4135	Rosema	Set Kent County Monument
1995	LCRC #8211	Breitels	Kent County Monument

The position of this corner was previously approved by the Kent County Remonumentation Peer Group, monumented by Maurice J. Rosema on 11/20/84 and was recorded per LCRC #4135

B. Description of corner evidence found and/or method applied in restoring or reestablishing corner:


G-4 Found standard Kent Co. Mon. (Harrison) per witnesses from above LCRC as set by Maurice J. Rosema in place of the Capped Re-rod in a split stone he found. Said Capped Re-rod in stone checks with Kent Co. Wit. & Exxel Eng.

LCRC #4135	LCRC #8211
Nail & tag 18" Oak N10°W 18.20'	Nail & tag 20" Oak N10°W 18.28'
Nail & tag 10" Oak S65°W 20.54'	Nail & tag 15" Oak S65°W 20.57'
Nail & tag 8" Oak S47°E 8.95'	Nail & tag 12" Oak S47°E 8.99'
Nail & tag 24" Oak N72°E 52.67'	Nail & tag 28" Oak N72°E 52.90'
2" Steel post - S. 0.8' & E. 0.4'	2" steel post - S. 0.8' & E. 0.4'

The selected location is accepted by me and is generally accepted by professional surveyors as the best available evidence of the position of the original corner.

C. Description of monument for corner and accessories established to perpetuate locating the position of the corner:

G-4 Standard Kent County Monument			
Nail & KC Remon. tag W. side	20" Oak	N10°W	18.20'
Nail & KC Remon. tag N. side	15" Oak	S65°W	20.54'
Nail & KC Remon. tag SW side	12" Oak	S47°E	8.99'
Nail & KC Remon. tag S. side	28" Oak	N72°E	52.80'
2" Steel post at ground level - S. 0.8' and E. 0.4'			
Centerline Grand River Dr. - N. 130' m/1			

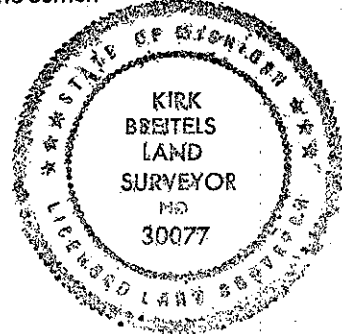

Signed by Kirk Breitels  
Surveyor's Michigan License No. 30077

Date 3/27/97

P.A. 345 1990 KENT COUNTY

PEER APPROVED 3/27/97  
CHAIRMAN [Signature]

FORM APPROVED BY MICHIGAN STATE BOARD OF PROFESSIONAL SURVEYORS, JAN. 28, 1971  
REVISED MAY 14, 1975  
REVISED JAN., 1983  
REVISED OCT., 1985