

SURVEY & REMONUMENTATION

MAR 03 1998

KENT COUNTY REMONUMENTATION

SECTION

LAND CORNER RECORDATION CERTIFICATE Filing Requirement of Act 74, Mich. P.A. 1970

For corners in
KENT COUNTY

Located In: Corner Code #

1. Public Land Survey	T	6N	R	9W	G-7
	T		R		
	T		R		
	T		R		
2. Property Controlling in Section	S		T	R	
	S		T	R	
3. Miscellaneous Property in Sec.	S		T	R	
	S		T	R	

STATE OF MICHIGAN
COUNTY OF KENT
RECEIVED FOR RECORD
97 APR 29 AM 8:22
REG. OF DEEDS
9841
Register of Deeds Stamp & File Number

4. Lot No. _____, Recorded Plat _____
5. Private Claims _____

I, Kirk Breitels, in a field survey on Jan. 27, 1997 do hereby state that under requirements of P.A. 74, Michigan P.A. of 1970, the corner points mentioned in lines 1 and 2 above were in conformance with regulations and rules therefore as required in the current manual of survey instructions of the United States Department of the Interior, Bureau of Land Management or by a decree of a Court of Law and /or that the corner points mentioned in lines 3, 4 and 5 above were in conformance with the rules of the Michigan Board of Land Surveyors or by a Decree of a Court of Law; established, re-established, monumented, recovered, found as expressed below:

A	B	C	D	E	F	G	H	I	J	K	L	M
1												
2	6	5	4	3	2	1						
3												
4	7	8	9	10	11	12						
5												
6	18	17	16	15	14	13						
7												
8	19	20	21	22	23	24						
9												
10	30	29	28	27	26	25						
11												
12	31	32	33	34	35	36						
13												

NOTE: Not more than 2 corners, all in the same town and range, may be recorded on this certificate.

A. Description of original monument and accessories and/or subsequent restoration:

G-7	1830	GLO	Mullett	Set Post
	1973	LCRC #602	VanKooten	1" Round Iron in mon. box
	1982	LCRC #3286	Hay	Set Kent County Monument
	1995	LCRC #8214	Breitels	Kent County Monument in Mon. Box

The position of this corner was previously approved by the Kent County Remonumentation Peer Group, monumented by C. S. Hay on 4/1/82 and was recorded per LCRC #3286.


B. Description of corner evidence found and/or method applied in restoring or reestablishing corner:
G-7 Found standard Kent Co. Mon. (Harrison) per witnesses from above LCRC as set by C. S. Hay in place of the Round Iron he found inside a mon. box. Said Round Iron checks with LCRC #602.

LCRC #3286	LCRC #8214
PK Nail & tag curb joint N50°W 40.36'	Nail & tag MBT Pole N62°E 103.28'
PK Nail & tag curb joint N48°E 41.03'	Nail & tag P. Pole S35°E 108.30'
PK Nail & tag curb joint S62°W 41.31'	Nail & tag 10" Poplar N40°W 88.07'
Nail & tag MBT Pole N62°E 103.23'	Nail & tag 12" Pine N40°W 73.87'
Nail & tag P. Pole S35°E 108.25'	

The selected location is accepted by me and is generally accepted by professional surveyors as the best available evidence of the position of the original corner.

C. Description of monument for corner and accessories established to perpetuate locating the position of the corner:

G-7 Standard Kent County Monument in Mon. Box	
Nail & KC Remon. tag SE side MBT Pole	N62°E 103.28'
Nail & KC Remon. tag NE side P. Pole	S35°E 108.30'
Nail & KC Remon. tag N. side 10" Poplar	S70°W 88.07'
Nail & KC Remon. tag NE side 12" Pine	N40°W 73.87'
On C/L "X" pavement	

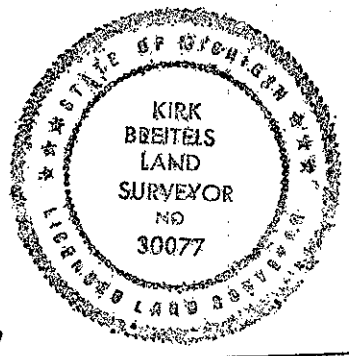

Signed by Kirk Breitels
Surveyor's Michigan License No. 30077

Date 3/27/97

P.A. 345 1990 KENT COUNTY
PEER APPROVED 3/27/97
CHAIRMAN Harry Hubert