

**SURVEY & REMONUMENTATION**

**MAR 03 1998**

**KENT COUNTY REMONUMENTATION**

**SECTION**

**LAND CORNER RECORDATION CERTIFICATE**  
Filing Requirement of Act 74, Mich. P.A. 1970

STATE OF MICHIGAN  
 COUNTY OF KENT  
 RECEIVED FOR RECORD  
 57 APR 29 AM 8:23  
 REG. OF DEEDS  
*Lucy Standa*

For corners in

KENT COUNTY

(County)

Located in:

Corner Code #

1. Public Land Survey	T <u>6N</u> R <u>9W</u>	<u>G-11</u>
	T <u>    </u> R <u>    </u>	<u>    </u>
	T <u>    </u> R <u>    </u>	<u>    </u>
	T <u>    </u> R <u>    </u>	<u>    </u>
2. Property Controlling in Section	S <u>    </u> T <u>    </u> R <u>    </u>	<u>    </u>
	S <u>    </u> T <u>    </u> R <u>    </u>	<u>    </u>
3. Miscellaneous Property in Sec.	S <u>    </u> T <u>    </u> R <u>    </u>	<u>    </u>
	S <u>    </u> T <u>    </u> R <u>    </u>	<u>    </u>

**9845**

Register of Deeds Stamp & File Number

4. Lot No. \_\_\_\_\_, Recorded Plat \_\_\_\_\_  
 5. Private Claims \_\_\_\_\_

I, Kirk Breitels, in a field survey on Jan. 27, 1997 do hereby state that under requirements of P.A. 74, Michigan P.A. of 1970, the corner points mentioned in lines 1 and 2 above were in conformance with regulations and rules therefore as required in the current manual of survey instructions of the United States Department of the Interior, Bureau of Land Management or by a decree of a Court of Law and /or that the corner points mentioned in lines 3, 4 and 5 above were in conformance with the rules of the Michigan Board of Land Surveyors or by a Decree of a Court of Law, established, re-established, monumented, recovered, found as expressed below:

NOTE: Not more than 2 corners, all in the same town and range, may be recorded on this certificate.

1	A	B	C	D	E	F	G	H	I	J	K	L	M
2		6		5		4		3		2		1	
3													
4		7		8		9		10		11		12	
5													
6		18		17		16		15		14		13	
7													
8		19		20		21		22		23		24	
9													
10		30		29		28		27		26		25	
11													
12		31		32		33		34		35		36	
13													

A. Description of original monument and accessories and/or subsequent restoration:

G-11	1830	GLO	Mullett	Set Post
	1944	Kent Co. Wit.		Iron in pavement
	1982	LCRC #2887	Jonker	1/2" Rod in mon. box
	1982	LCRC #3086	Jonker	Set Kent County Monument in mon. box
	1995	LCRC #8218	Breitels	Kent County Monument

The position of this corner was previously approved by the Kent County Remonumentation Peer Group, monumented by Robert J. Jonker on 9/15/82 and was recorded per LCRC #3086.

B. Description of corner evidence found and/or method applied in restoring or reestablishing corner:

G-11 Found standard Kent Co. Mon. (Harrison) per witnesses from above LCRC as set by Robert J. Jonker in place of the 1/2" Copperweld Rod he found inside a mon. box. Said Copperweld Rod checks with LCRC #2887. No witnesses from Kent Co. remain.

<u>LCRC #3086</u>		<u>LCRC #8218</u>
Remon. tag P. Pole	N40°W 49.0'	Nail & tag P. Pole N40°W 49.04'
Remon. tag cor. fe. post	S50°W 46.02'	Nail & tag P. Pole S45°W 46.13'
Remon. tag cor. fe. post	S50°E 45.50'	Nail & tag 16" Maple N65°E 47.44'
Remon. tag 26" Maple	N25°E 68.82'	Nail & tag 36" Maple N25°E 67.91'

On C/L "X" of pavement C/L N-S pavement is E. 1'±, On C/L E-W


The selected location is accepted by me and is generally accepted by professional surveyors as the best available evidence of the position of the original corner.

C. Description of monument for corner and accessories established to perpetuate locating the position of the corner:

G-11 Standard Kent County Monument

Nail & KC Remon. tag SW side P. Pole	N40°W 49.04'
Nail & KC Remon. tag SE side P. Pole	S45°W 46.13'
Nail & KC Remon. tag S. side 18" Maple	N65°E 47.44'
Nail & KC Remon. tag W. side 38" Maple	N25°E 67.91'

C/L N-S pavement is East 1' m/l, On C/L E-W road m/l

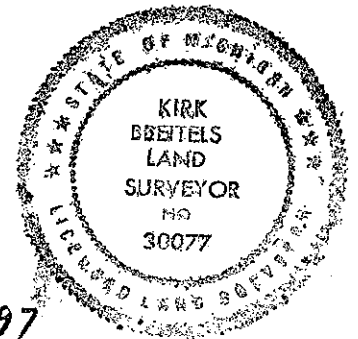

Signed by *Kirk Breitels*  
 Surveyor's Michigan License No. 30077

Date 3/27/97

P.A. 345 1990 KENT COUNTY  
 PEER APPROVED 3/27/97  
 CHAIRMAN *Frank Hubbell*