

SURVEY & REMONUMENTATION

MAR 03 1998

KENT COUNTY REMONUMENTATION

SECTION

LAND CORNER RECORDATION CERTIFICATE
Filing Requirement of Act 74, Mich. P.A. 1970

For corners in
KENT COUNTY
(County)

Located In:	Corner Code #
1. Public Land Survey	T 6N R 9W G-12
	T R
	T R
	T R
	T R
2. Property Controlling in Section	S T R
	S T R
3. Miscellaneous Property in Sec.	S T R
	S T R

STATE OF MICHIGAN
COUNTY OF KENT
RECEIVED FOR RECORD
97 APR 29 AM 8:23
REG. OF DEEDS
Lucy Standa

9846

Register of Deeds Stamp & File Number

4. Lot No. _____, Recorded Plat _____
5. Private Claims _____

I, Kirk Breitels, in a field survey on Jan. 23, 1997 do hereby state that under requirements of P.A. 74, Michigan P.A. of 1970, the corner points mentioned in lines 1 and 2 above were in conformance with regulations and rules therefore as required in the current manual of survey instructions of the United States Department of the Interior, Bureau of Land Management or by a decree of a Court of Law and /or that the corner points mentioned in lines 3, 4 and 5 above were in conformance with the rules of the Michigan Board of Land Surveyors or by a Decree of a Court of Law; established, re-established, monumented, recovered, found as expressed below:

	A	B	C	D	E	F	G	H	I	J	K	L	M
1													
2		6		5		4		3		2		1	
3													
4		7		8		9		10		11		12	
5													
6		18		17		16		15		14		13	
7													
8		19		20		21		22		23		24	
9													
10		30		29		28		27		26		25	
11													
12		31		32		33		34		35		36	
13													

NOTE: Not more than 2 corners, all in the same town and range, may be recorded on this certificate.

A. Description of original monument and accessories and/or subsequent restoration:

G-12	1830	GLO	Mullett	Set Post
		Kent Co. Wit.		Iron
	1982	LCRC #2887	Jonker	1" Solid Bar in Mon. Box
	1982	LCRC #3087	Jonker	Set Kent County Monument in Mon. Box
	1995	LCRC #8219	Breitels	Kent County Monument

The position of this corner was previously approved by the Kent County Remonumentation Peer Group, monumented by Robert J. Jonker on 9/15/82 and was recorded per LCRC #3087

B. Description of corner evidence found and/or method applied in restoring or reestablishing corner:


G-12 Found standard Kent Co. Mon. (Harrison) per witnesses from above LCRC as set by Robert J. Jonker in place of the 1" Solid Bar he found inside a Mon. Box. Said Solid Bar checks with Kent Co. Wit. and LCRC #2887.

LCRC #3087	LCRC #8219		
Remon. tag fc. post	N90°E 27.2'	Nail & tag fence post	N90°E 27.46'
Remon. tag 18" Tw. Pignut	S85°W 41.16'	Nail & tag 24" Tw. Pignut	S85°W 41.12'
C/L gas vent pipe	N40°E 48.9'	C/L gas vent pipe	N40°E 48.90'
C/L gas vent pipe	N45°W 53.08'	C/L gas vent pipe	N45°W 53.08'
		Nail & tag 20" Walnut	S50°W 52.67'

The selected location is accepted by me and is generally accepted by professional surveyors as the best available evidence of the position of the original corner.

C. Description of monument for corner and accessories established to perpetuate locating the position of the corner:

G-12 Standard Kent County Monument			
Nail & KC Remon. tag S. side fence post	N90°E	27.46'	
Nail & KC Remon. tag N. side 24" Tw. Pignut	S85°W	41.12'	
C/L gas vent pipe	N40°E	48.90'	
C/L gas vent pipe	N45°W	53.08'	
Nail & KC Remon. tag SE side 24" Walnut	S50°W	52.67'	
On fence line E-W			
C/L N-S pavement is 6'± W.			

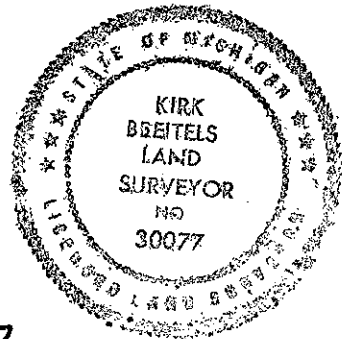

Signed by *Kirk Breitels*
Surveyor's Michigan License No. 30077

Date 3/27/97

P.A. 345 1990 KENT COUNTY
PEER APPROVED 3/27/97
CHAIRMAN *Harry Hubert*