

MAR 03 1998

KENT COUNTY REMONUMENTATION

SECTION

LAND CORNER RECORDATION CERTIFICATE
Filing Requirement of Act 74, Mich. P.A. 1970

STATE OF MICHIGAN
COUNTY OF KENT
RECEIVED FOR RECORD
97 APR 29 AM 8:23
REG. OF DEEDS
Lucy Howard

For corners in
KENT COUNTY
(County)

Located In:	Corner Code #
T 6N R 9W	H-3
T R	
T R	
T R	
S T R	
S T R	
S T R	
S T R	

- Public Land Survey
- Property Controlling in Section
- Miscellaneous Property in Sec.

9849

Register of Deeds Stamp & File Number

- Lot No. _____, Recorded Plat _____
- Private Claims _____

I, Kirk Breitels, in a field survey on Jan. 17, 1997 do hereby state that under requirements of P.A. 74, Michigan P.A. of 1970, the corner points mentioned in lines 1 and 2 above were in conformance with regulations and rules therefore as required in the current manual of survey instructions of the United States Department of the Interior, Bureau of Land Management or by a decree of a Court of Law and/or that the corner points mentioned in lines 3, 4 and 5 above were in conformance with the rules of the Michigan Board of Land Surveyors or by a Decree of a Court of Law; established, re-established, monumented, recovered, found as expressed below:

NOTE: Not more than 2 corners, all in the same town and range, may be recorded on this certificate.

	A	B	C	D	E	F	G	H	I	J	K	L	M
1													
2	6		5		4			3		2			1
3								●					
4	7		8		9			10		11			12
5													
6	18		17		16			15		14			13
7													
8	19		20		21			22		23			24
9													
10	30		29		28			27		26			25
11													
12	31		32		33			34		35			36
13													

A. Description of original monument and accessories and/or subsequent restoration:

H-3	1830	GLO	Mullett	Set Post
	1973	LCRC #466	Spicer	1" Iron
	1981	LCRC #2222	Jonker	Set Kent County Monument
	1990	LCRC #5467	Starr	Kent County Monument

The position of this corner was previously approved by the Kent County Remonumentation Peer Group, monumented by Robert J. Jonker on 10-28-81 and was recorded per LCRC #2222

B. Description of corner evidence found and/or method applied in restoring or reestablishing corner:


H-3 Found standard Kent Co. Mon. (Harrison) per witnesses from above LCRC as set by Robert J. Jonker in place of the 1" Iron over a 3/4" Iron he found. Both Irons checks with LCRC #466.

LCRC #2222	LCRC #5467
P. Pole S58°E 52.55'	P. Pole S58°E 52.55'
P. Pole S78°W 113.26'	P. Pole S78°W 113.26'
NW cor. steel fc. post S15°W 23.41'	10" Hackberry N01°E 54.73'
C/L fc. & brush row N. is 2' W.	NW cor. steel fc. post S15°W 23.41'
C/L E-W B.T. is 1' N.	P. Pole N65°W 109.98'

The selected location is accepted by me and is generally accepted by professional surveyors as the best available evidence of the position of the original corner.

C. Description of monument for corner and accessories established to perpetuate locating the position of the corner:

H-3 Standard Kent County Monument	
Nail & KC Remon. tag NE side P. Pole	S58°E 52.55'
Nail & KC Remon. tag N. side P. Pole	S78°W 113.26'
Nail & KC Remon. tag E. side 12" Hackberry	N01°E 54.69'
Nail & KC Remon. tag S. side P. Pole	N65°W 109.98'
C/L fence & brush row to N. is 2' W.	
C/L E-W blacktop road is 1' N.	

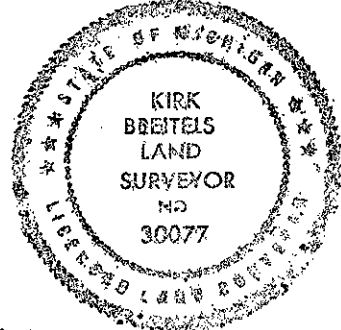

Signed by *Kirk Breitels*
Surveyor's Michigan License No. 30077

Date 3/27/97

P.A. 345 1990 KENT COUNTY
PEER APPROVED 3/27/97
CHAIRMAN *Harry Kubes*