

SURVEY & REMONUMENTATION

MAR 03 1998

KENT COUNTY REMONUMENTATION

SECTION

LAND CORNER RECORDATION CERTIFICATE
Filing Requirement of Act 74, Mich. P.A. 1970

For corners in

KENT COUNTY

(County)

Located In:

Corner Code #

1. Public Land Survey	T <u>6N</u> R <u>9W</u>	H-5
	T <u> </u> R <u> </u>	<u> </u>
	T <u> </u> R <u> </u>	<u> </u>
	T <u> </u> R <u> </u>	<u> </u>
2. Property Controlling in Section	S <u> </u> T <u> </u> R <u> </u>	<u> </u>
	S <u> </u> T <u> </u> R <u> </u>	<u> </u>
3. Miscellaneous Property in Sec.	S <u> </u> T <u> </u> R <u> </u>	<u> </u>
	S <u> </u> T <u> </u> R <u> </u>	<u> </u>

STATE OF MICHIGAN
COUNTY OF KENT
RECEIVED FOR RECORD
97 APR 29 AM 8:23
REG. OF DEEDS
Lucy Bond

9850

Register of Deeds Stamp & File Number

4. Lot No. _____, Recorded Plat _____
5. Private Claims _____

I, Kirk Breitels, in a field survey on Jan. 17, 19 97 do hereby state that under requirements of P.A. 74, Michigan P.A. of 1970, the corner points mentioned in lines 1 and 2 above were in conformance with regulations and rules therefore as required in the current manual of survey instructions of the United States Department of the Interior, Bureau of Land Management or by a decree of a Court of Law and/or that the corner points mentioned in lines 3, 4 and 5 above were in conformance with the rules of the Michigan Board of Land Surveyors or by a Decree of a Court of Law; established, re-established, monumented, recovered, found as expressed below:

NOTE: Not more than 2 corners, all in the same town and range, may be recorded on this certificate.

A	B	C	D	E	F	G	H	I	J	K	L	M
1												
2	6	5	4	3	2	1						
3												
4	7	8	9	10	11	12						
5												
6	10	17	16	15	14	13						
7												
8	19	20	21	22	23	24						
9												
10	30	29	28	27	26	25						
11												
12	31	32	33	34	35	36						
13												

A. Description of original monument and accessories and/or subsequent restoration:

H-5	1830	GLO	Mullett	Set Post
	1968	Kent Co. Wit.		Pointed Stone
	1983	LCRC #3220	Bonnema	Pointed Stone
	1983	LCRC #3605	Kolehouse	Set Kent County Monument
	1990	LCRC #5468	Starr	Kent County Monument

The position of this corner was previously approved by the Kent County Remonumentation Peer Group, monumented by Randy J. Kolehouse on 11-1-83 and was recorded per LCRC #3605

B. Description of corner evidence found and/or method applied in restoring or reestablishing corner:


H-5 Found standard Kent Co. Mon. (Harrison) per witnesses from above LCRC as set by Randy J. Kolehouse in place of the Pointed Stone he found. Said Pointed Stone checks with Kent Co. Wit. and LCRC #3220.

<u>LCRC #3605</u>	Nail & tag P. Pole S25°W 68.0'	<u>LCRC #5468</u>	Nail & tag P. Pole S25°W 68.00'
	Nail & tag P. Pole East 79.9'		Nail & tag P. Pole East 79.90'
	Nail & tag 10" Pine S50°W 56.1'		Nail & tag 10" Pine S50°W 56.10'
	On line grav. rd. N. ext. S.		Nail & tag Tri. 10" Elm N60°W 97.65'
	On line grav. rd. W. ext. E.		

The selected location is accepted by me and is generally accepted by professional surveyors as the best available evidence of the position of the original corner.

C. Description of monument for corner and accessories established to perpetuate locating the position of the corner:

H-5	Standard Kent County Monument
	Nail & KC Remon. tag W. side P. Pole S25°W 68.00'
	Nail & KC Remon. tag N. side P. Pole East 79.42'
	Nail & KC Remon. tag NW side 20" Pine S50°W 56.10'
	Nail & KC Remon. tag W. side 8" Cherry N40°E 32.70'
	C/L grav. dr. E'ly-W'ly (at rt. angles) is SW'ly 14'±
	On line bit. rd. running N. ext. S.
	On line bit. rd. running W. ext. E.

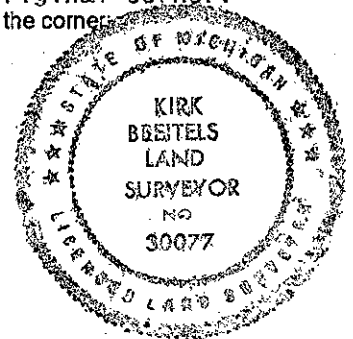

Signed by *Kirk Breitels*
Surveyor's Michigan License No. 30077

Date 3/27/97

P.A. 345 1990 KENT COUNTY
PEER APPROVED 3/27/97
CHAIRMAN *Randy Kolehouse*