

SURVEY & REMONUMENTATION

MAR 03 1998

KENT COUNTY REMONUMENTATION

SECTION

LAND CORNER RECORDATION CERTIFICATE
Filing Requirement of Act 74, Mich. P.A. 1970

For corners in
KENT COUNTY
(County)

Located In:	Corner Code #
T6N R9W	H-11
T R	
T R	
T R	
T R	
S T R	
S T R	
S T R	
S T R	

- 1. Public Land Survey
- 2. Property Controlling in Section
- 3. Miscellaneous Property in Sec.

STATE OF MICHIGAN
 COUNTY OF KENT
 RECEIVED FOR RECORD
 97 APR 29 AM 8:23
 REG. OF DEEDS

9853

Register of Deeds Stamp & File Number

- 4. Lot No. _____, Recorded Plat _____
- 5. Private Claims _____

I, Kirk Breitels, in a field survey on Jan. 17, 1997 do hereby state that under requirements of P.A. 74, Michigan P.A. of 1970, the corner points mentioned in lines 1 and 2 above were in conformance with regulations and rules therefore as required in the current manual of survey instructions of the United States Department of the Interior, Bureau of Land Management or by a decree of a Court of Law and /or that the corner points mentioned in lines 3, 4 and 5 above were in conformance with the rules of the Michigan Board of Land Surveyors or by a Decree of a Court of Law; established, re-established, monumented, recovered, found as expressed below:

NOTE: Not more than 2 corners, all in the same town and range, may be recorded on this certificate.

	A	B	C	D	E	F	G	H	I	J	K	L	M
1													
2	6		5		4		3		2		1		
3													
4	7		8		9		10		11		12		
5													
6	18		17		16		15		14		13		
7													
8	19		20		21		22		23		24		
9													
10	30		29		28		27		26		25		
11													
12	31		32		33		34		35		36		
13													

A. Description of original monument and accessories and/or subsequent restoration:

H-11	1830	GLO	Mullett	Set Post
		Kent Co. Wit.		1/2" Iron
	1982	LCRC #2889	Jonker	Boat Spike
	1982	LCRC #3091	Jonker	Set Kent County Monument
	1990	LCRC #5471	Starr	Kent County Monument

The position of this corner was previously approved by the Kent County Remonumentation Peer Group, monumented by Robert J. Jonker on 9-22-82 and was recorded per LCRC #3091

B. Description of corner evidence found and/or method applied in restoring or reestablishing corner:


H-11 Found standard Kent Co. Mon. (Harrison) per witnesses from above LCRC as set by Robert J. Jonker in place of the Boat Spike he found. Said Boat Spike checks with LCRC #2889.

LCRC #3091	LCRC #5471
Nail & tag 8" Elm N25°E 30.36'	Nail & tag 6" Ash N60°W 76.47'
Nail & tag 6" Ash S65°E 67.80'	Nail & tag 6" Maple N10°E 39.25'
"X" on S. end culv. S40°W 23.64'	Nail & tag 6" Tree N80°E 91.14'
"X" on N. end culv. N20°W 24.02'	"X" on S. end culv. S40°W 23.64'
C/L E-W pvt. 2' N. & on tree line N.	"X" on N. end culv. N20°W 24.02'

The selected location is accepted by me and is generally accepted by professional surveyors as the best available evidence of the position of the original corner.

C. Description of monument for corner and accessories established to perpetuate locating the position of the corner:

H-11 Standard Kent County Monument	
Nail & KC Remon. tag N. side 8" Ash	N60°W 76.03'
Nail & KC Remon. tag E. side 8" Maple	N10°E 39.20'
Nail & KC Remon. tag W. side Tri. 6" Ash	N40°E 36.61'
"X" cut on S. end culvert	S40°W 23.64'
"X" cut on N. end culvert	N20°W 24.02'
On tree line North	
C/L E-W bit road is 2' North	

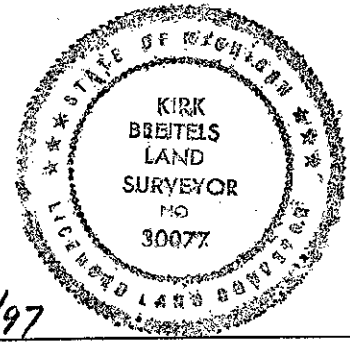

Signed by Kirk Breitels
Surveyor's Michigan License No. 30077

Date 3/27/97

P.A. 345 1990 KENT COUNTY
PEER APPROVED 3/27/97
CHAIRMAN Harry Huber
FORM APPROVED BY MICHIGAN STATE BOARD OF PROFESSIONAL SURVEYORS, JAN. 28, 1971
REVISED MAY 14, 1975
REVISED JAN., 1983
REVISED OCT., 1995