

**SURVEY & REMONUMENTATION**

MAR 03 1998

**KENT COUNTY REMONUMENTATION**

**SECTION**

**LAND CORNER RECORDATION CERTIFICATE**  
Filing Requirement of Act 74, Mich. P.A. 1970

For corners in  
KENT COUNTY

(County)

Located In:

Corner Code #

1. Public Land Survey	T <u>6N</u> R <u>9W</u>	H-12
	T _____ R _____	_____
	T _____ R _____	_____
	T _____ R _____	_____
2. Property Controlling in Section	S _____ T _____ R _____	_____
	S _____ T _____ R _____	_____
3. Miscellaneous Property in Sec.	S _____ T _____ R _____	_____
	S _____ T _____ R _____	_____

STATE OF MICHIGAN  
COUNTY OF KENT  
RECEIVED FOR RECORD

97 OCT 14 AM 10:32

REG. OF DEEDS

*Lucy Starnes*

**10066**

Register of Deeds Stamp & File Number

4. Lot No. \_\_\_\_\_, Recorded Plat \_\_\_\_\_  
5. Private Claims \_\_\_\_\_

I, Kirk Breitels, in a field survey on June 17 97, 19\_\_\_\_ do hereby state that under requirements of P.A. 74, Michigan P.A. of 1970, the corner points mentioned in lines 1 and 2 above were in conformance with regulations and rules therefore as required in the current manual of survey instructions of the United States Department of the Interior, Bureau of Land Management or by a decree of a Court of Law and /or that the corner points mentioned in lines 3, 4 and 5 above were in conformance with the rules of the Michigan Board of Land Surveyors or by a Decree of a Court of Law; established, re-established, monumented, recovered, found as expressed below:

NOTE: Not more than 2 corners, all in the same town and range, may be recorded on this certificate.

A	B	C	D	E	F	G	H	I	J	K	L	M
1												
2	6		5		4		3		2		1	
3												
4	7		8		9		10		11		12	
5												
6	18		17		16		15		14		13	
7												
8	19		20		21		22		23		24	
9												
10	30		29		28		27		26		25	
11												
12	31		32		33		34		35		36	
13												

**A. Description of original monument and accessories and/or subsequent restoration:**

H-12 1830---GLO---Not Set  
Williams & Works---No information  
Kent Co. Wits.---No information  
1996---Survey---Prein & Newhof---Set Rebar at intersection of 1/4 lines  
N05°E 11.80' Tri. 6" Elm      N45°E 35.51' 8" Elm  
N85°E 21.10' 16" Beech      S35°E 8.58' 12" Maple

P.A. 345 1990 KENT COUNTY  
PEER APPROVED 7/24/97  
CHAIRMAN *Harry Fisher*


**B. Description of corner evidence found and/or method applied in restoring or reestablishing corner:**

H-12 Did not find Rebar as set by Prein & Newhof. Found witness nails in trees and established corner per witnesses. Location per witnesses is 0.3' W. & 0.4' S. of intersection of 1/4 lines. Computed Intersection of 1/4 lines fits Prein & Newhof section measurements than better location per witnesses. Old fence post for fence to N-S and W. is 7' South and 2' West.

The Intersection of 1/4 lines is accepted by me and is generally accepted by professional surveyors as the best available evidence of the position of the corner.

**C. Description of monument for corner and accessories established to perpetuate locating the position of the corner:**

H-12 Set Standard Kent Co. Monument (Harrison) at the Intersection of 1/4 lines.  
Nail & KC Remon. tag SW side 12" Elm      S25°E 8.70'  
Nail & KC Remon. tag W. side fence cor. post      S15°E 3.47'  
Nail & KC Remon. tag E. side Tri. 6" Elm      N05°E 11.46'  
Nail & KC Remon. tag NW side 8" Elm      N45°E 35.04'  
Nail & KC Remon. tag N. side 22" Beech      N85°E 20.81'

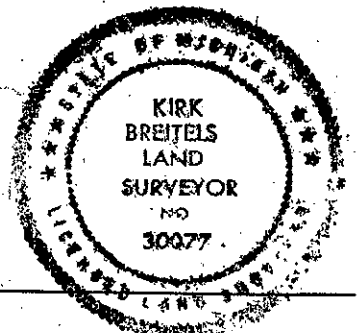

Signed by *Kirk Breitels*  
Surveyor's Michigan License No. 30077

Date 9/22/97