

**SURVEY & REMONUMENTATION**

MAR 03 1998

**KENT COUNTY REMONUMENTATION**

**SECTION**

**LAND CORNER RECORDATION CERTIFICATE**  
Filing Requirement of Act 74, Mich. P.A. 1970

For corners in

KENT COUNTY

(County)

Located In:

Corner Code #

1. Public Land Survey

T 6N R 9W

I-1

T \_\_\_\_\_ R \_\_\_\_\_

T \_\_\_\_\_ R \_\_\_\_\_

T \_\_\_\_\_ R \_\_\_\_\_

2. Property Controlling in Section

S \_\_\_\_\_

T \_\_\_\_\_ R \_\_\_\_\_

S \_\_\_\_\_

T \_\_\_\_\_ R \_\_\_\_\_

3. Miscellaneous Property in Sec.

S \_\_\_\_\_

T \_\_\_\_\_ R \_\_\_\_\_

S \_\_\_\_\_

T \_\_\_\_\_ R \_\_\_\_\_

4. Lot No. \_\_\_\_\_, Recorded Plat \_\_\_\_\_

5. Private Claims \_\_\_\_\_

STATE OF MICHIGAN  
COUNTY OF KENT  
RECEIVED FOR RECORD  
97 APR 29 AM 8:23  
REG. OF DEEDS  
9854  
Register of Deeds Stamp & File Number

I, Kirk Breitels, in a field survey on Jan. 10, 1997 do hereby state that under requirements of P.A. 74, Michigan P.A. of 1970, the corner points mentioned in lines 1 and 2 above were in conformance with regulations and rules therefore as required in the current manual of survey instructions of the United States Department of the Interior, Bureau of Land Management or by a decree of a Court of Law and for that the corner points mentioned in lines 3, 4 and 5 above were in conformance with the rules of the Michigan Board of Land Surveyors or by a Decree of a Court of Law; established, re-established, monumented, recovered, found as expressed below:

A	B	C	D	E	F	G	H	I	J	K	L	M
1												
2	6		5		4		3		2		1	
3												
4	7		8		9		10		11		12	
5												
6	18		17		16		15		14		13	
7												
8	19		20		21		22		23		24	
9												
10	30		29		28		27		26		25	
11												
12	31		32		33		34		35		36	
13												

NOTE: Not more than 2 corners, all in the same town and range, may be recorded on this certificate.

A. Description of original monument and accessories and/or subsequent restoration:

I-1	1830	GLO	Mullett	Set Post
	1968	Kent Co. Wit.		1" Iron
	1973	LCRC #403	Spicer	1" Iron
	1973	LCRC #488	Spicer	"T" Iron
	1985	LCRC #4207	Rosema	Set Kent County Monument on twp. line
	1995	LCRC #8288	Byl	Kent County Monument

The position of this corner was previously approved by the Kent County Remonumentation Peer Group, monumented by Maurice J. Rosema on 3/7/85 and was recorded per LCRC #4207

B. Description of corner evidence found and/or method applied in restoring or reestablishing corner:


I-1 Found standard Kent Co. Mon. (Harrison) per witnesses from above LCRC as set by Maurice J. Rosema in place of the 1 1/4" Iron he found with a MVK cap. Said Iron checks with Kent Co. Wit. and LCRC's #403 & #488.

<u>LCRC #4207</u>	I-13, 7-9	East	54.98'	<u>LCRC #8288</u>	same witnesses as LCRC #4207
	SW cor. house siding	N15°W	79.30'		
	Nail & tag side 30" Maple	N42°W	39.45'		
	SE cor. wood hse. siding	N19°E	70.26'		
	Nail & tag 12" Pine	N73°E	7.31'		
	Face of conc. fc. post	South	1.81'		

The selected location is accepted by me and is generally accepted by professional surveyors as the best available evidence of the position of the original corner.

C. Description of monument for corner and accessories established to perpetuate locating the position of the corner:

I-1 Standard Kent County Monument					
SW corner siding of house		N15°W	79.30'		
Nail & KC Remon. tag SW side 32" Maple		N42°W	39.48'		
SE corner wood siding of house		N19°E	70.26'		
Nail & KC Remon. tag SE side 15" Pine		N73°E	7.29'		
Face of 0.8' x 0.8' conc. cor. fence post		S00°E	1.78'		
I-13, T7N, R9W (Kent Co. Mon.)		S90°E	54.95'		

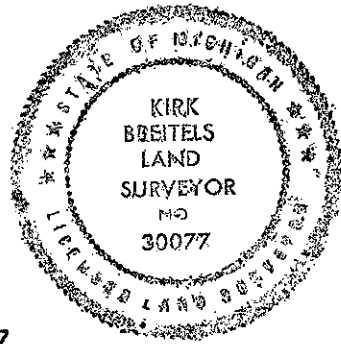

Signed by Kirk Breitels  
Surveyor's Michigan License No. 30077

Date 3/27/97

P.A. 345 1990 KENT COUNTY

PEER APPROVED 3/27/97

CHAIRMAN Harry Hubers

FORM APPROVED BY MICHIGAN STATE BOARD OF PROFESSIONAL SURVEYORS, JAN. 28, 1971  
REVISED MAY 14, 1975  
REVISED JAN., 1983  
REVISED OCT., 1985