

SURVEY & REMONUMENTATION

MAR 03 1998

KENT COUNTY REMONUMENTATION

SECTION

LAND CORNER RECORDATION CERTIFICATE
Filing Requirement of Act 74, Mich. P.A. 1970

For corners in

KENT COUNTY

(County)

Located In:

Corner Code #

1. Public Land Survey	T <u>6N</u> R <u>9W</u>	I-3
	T <u> </u> R <u> </u>	<u> </u>
	T <u> </u> R <u> </u>	<u> </u>
	T <u> </u> R <u> </u>	<u> </u>
2. Property Controlling in Section	S <u> </u> T <u> </u> R <u> </u>	<u> </u>
	S <u> </u> T <u> </u> R <u> </u>	<u> </u>
3. Miscellaneous Property in Sec.	S <u> </u> T <u> </u> R <u> </u>	<u> </u>
	S <u> </u> T <u> </u> R <u> </u>	<u> </u>

REG. OF DEEDS

Eric J. Bond

97 JUN -3 AM 8:11

STATE OF MICHIGAN
COUNTY OF KENT
RECEIVED FOR RECORD

9995

Register of Deeds Stamp & File Number

4. Lot No. _____, Recorded Plat _____
5. Private Claims _____

I, Kirk Breitels, in a field survey on May 6, 1997 do hereby state that under requirements of P.A. 74, Michigan P.A. of 1970, the corner points mentioned in lines 1 and 2 above were in conformance with regulations and rules therefore as required in the current manual of survey instructions of the United States Department of the Interior, Bureau of Land Management or by a decree of a Court of Law and /or that the corner points mentioned in lines 3, 4 and 5 above were in conformance with the rules of the Michigan Board of Land Surveyors or by a Decree of a Court of Law; established, re-established, monumented, recovered, found as expressed below:

NOTE: Not more than 2 corners, all in the same town and range, may be recorded on this certificate.

	A	B	C	D	E	F	G	H	I	J	K	L	M
1													
2		6		5		4		3		2		1	
3									●				
4		7		8		9		10		11		12	
5													
6		10		17		16		15		14		13	
7													
8		19		20		21		22		23		24	
9													
10		30		29		28		27		26		25	
11													
12		31		32		33		34		35		36	
13													

A. Description of original monument and accessories and/or subsequent restoration:

I-3	1830	GLO	Mullett	Set Post
	1966	Kent Co. Wit.		Iron
	1972	LCRC #339	Spicer	1" Iron
	1981	LCRC #2224	Jonker	Set Kent County Monument
	1990	LCRC #5474	Starr	Kent County Monument

The position of this corner was previously approved by the Kent County Remonumentation Peer Group, monumented by Robert J. Jonker on 10/28/81 and was recorded per LCRC #2224

B. Description of corner evidence found and/or method applied in restoring or reestablishing corner:


I-3 Set Standard Kent Co. Mon. (Harrison) at the same location per witnesses from above LCRC for Kent Co. Mon. set in 1981 by Robert J. Jonker in place of the 1" Iron over 2" Well Point he found. Both Irons check with Kent Co. Wit. and LCRC #339.

<u>LCRC #2224</u>	<u>LCRC #5474</u>
MSHD tag P. Pole N30°W 31.21'	MSHD tag P. Pole N30°W 31.21'
Remon. tag P. Pole S74°W 74.83'	Nail & tag P. Pole S74°W 74.83'
Remon. tag 12" Oak N07°E 35.81'	Nail & tag 12" Oak N07°E 35.81'
Remon. tag P. Pole S60°E 51.00'	Nail & tag P. Pole S60°E 51.00'
Remon. tag 36" Maple S18°W 40.75'	Nail & tag 36" Maple S18°W 40.80'
C/L manhole S36°E 31.53'	

The selected location is accepted by me and is generally accepted by professional surveyors as the best available evidence of the position of the original corner.

C. Description of monument for corner and accessories established to perpetuate locating the position of the corner:

I-3	Standard Kent County Monument
	Nail & MSHD tag SW side P. Pole N30°W 31.21'
	Nail & KC Remon. tag SE side P. Pole S74°W 74.88'
	Nail & KC Remon. tag W. side 16" Oak N07°E 35.80'
	Nail & KC Remon. tag SW side P. Pole S60°E 51.03'
	Nail & KC Remon. tag W. side 38" Maple S18°W 40.82'
	On C/L E-W blacktop road.
	On tree line to N.

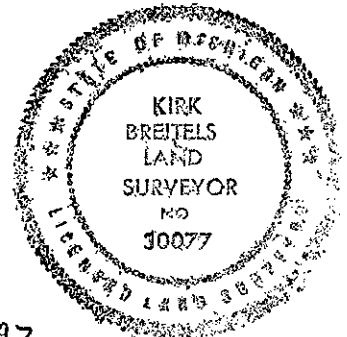

Signed by *Kirk Breitels*
Surveyor's Michigan License No. 30077

Date 5/22/97

P.A. 345 1990 KENT COUNTY
PEER APPROVED 5/22/97
CHAIRMAN *Harry Huber*