

SURVEY & REMONUMENTATION

MAR 03 1998

KENT COUNTY REMONUMENTATION

SECTION

LAND CORNER RECORDATION CERTIFICATE
Filing Requirement of Act 74, Mich. P.A. 1970

For corners in

KENT COUNTY

(County)

Located In:

Corner Code #

1. Public Land Survey

T 6N R 9W

I-4

T R

T R

T R

T R

2. Property Controlling in Section

S

T R

3. Miscellaneous Property in Sec.

S


T R

S

T R

4. Lot No. _____, Recorded Plat _____

5. Private Claims _____

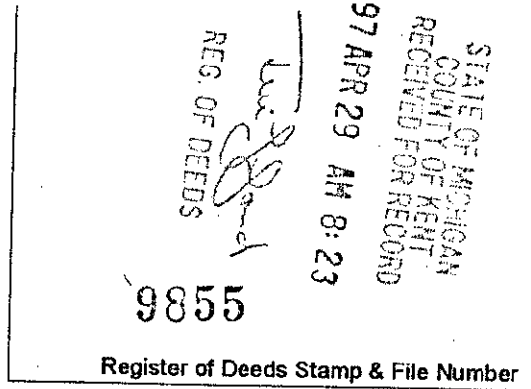

I, Kirk Breitels, in a field survey on Jan. 17, 1997 do hereby state that under requirements of P.A. 74, Michigan P.A. of 1970, the corner points mentioned in lines 1 and 2 above were in conformance with regulations and rules therefore as required in the current manual of survey instructions of the United States Department of the Interior, Bureau of Land Management or by a decree of a Court of Law and/or that the corner points mentioned in lines 3, 4 and 5 above were in conformance with the rules of the Michigan Board of Land Surveyors or by a Decree of a Court of Law; established, re-established, monumented, recovered, found as expressed below:

NOTE: Not more than 2 corners, all in the same town and range, may be recorded on this certificate.

	A	B	C	D	E	F	G	H	I	J	K	L	M
1													
2	6		5		4		3		2		1		
3													
4	7		8		9		10		11		12		
5													
6	18		17		16		15		14		13		
7													
8	19		20		21		22		23		24		
9													
10	30		29		28		27		26		25		
11													
12	31		32		33		34		35		36		
13													

A. Description of original monument and accessories and/or subsequent restoration:

I-4	1830	GLO	Mullett	Set Post
	1984	LCRC #4057	Nederveld	Set Capped Iron per information from Kent Co. surveyor's office
	1985	LCRC #4142	Rosema	Set Kent County Monument
	1990	LCRC #5475	Starr	Kent County Monument

The position of this corner was previously approved by the Kent County Remonumentation Peer Group, monumented by Maurice J. Rosema on 3-7-85 and was recorded per LCRC #4142

B. Description of corner evidence found and/or method applied in restoring or reestablishing corner:

I-4 Found standard Kent Co. Mon. (Harrison) per witnesses from above LCRC as set by Maurice J. Rosema in place of the 1/2" Capped Rerod he found. Said Rerod checks with LCRC #4057.

LCRC #4142

LCRC #5475

same witnesses as LCRC #4142.

Nail & tag 12" Oak	N51°E	34.30'
Nail & tag Tw. 8" Oak	N25°E	13.59'
Nail & tag cl. 6" Oaks	N78°W	8.14'
Nail & tag 10" Oak	N88°W	22.90'
Nail & tag 10" Oak	S48°E	14.42'

The selected location is accepted by me and is generally accepted by professional surveyors as the best available evidence of the position of the original corner.

C. Description of monument for corner and accessories established to perpetuate locating the position of the corner:

I-4 Standard Kent County Monument

Nail & KC Remon. tag S. side 16" Oak	N51°E	34.30'
Nail & KC Remon. tag SE side Tw. 10" Oak	N25°E	13.69'
Nail & KC Remon. tag S. side cl. dead 6" Oak	N78°W	8.08'
Nail & KC Remon. tag S. side 12" Oak	N88°W	22.90'
Nail & KC Remon. tag NE side 14" Oak	S48°E	14.46'
C/L Grand River Dr. is North 50'±		



Signed by Kirk Breitels
Surveyor's Michigan License No. 30077

Date 3/27/97

P.A. 345 1990 KENT COUNTY

PEER APPROVED 3/27/97

CHAIRMAN Harry Huber