

SURVEY & REMONUMENTATION

MAR 03 1998

KENT COUNTY REMONUMENTATION

LAND CORNER RECORDATION CERTIFICATE
Filing Requirement of Act 74, Mich. P.A. 1970

SECTION

For corners in

KENT COUNTY

(County)

Located In:

Corner Code #


1. Public Land Survey	T 6N R 9W	I-5
	T R	
	T R	
	T R	
2. Property Controlling in Section	S T R	
	S T R	
3. Miscellaneous Property in Sec.	S T R	
	S T R	

STATE OF MICHIGAN
COUNTY OF KENT
RECEIVED FOR RECORD
97 APR 29 AM 8:23
REG. OF DEEDS
Lucy Standa
9856
Register of Deeds Stamp & File Number

4. Lot No. _____, Recorded Plat _____
5. Private Claims _____

I, Kirk Breitels, in a field survey on Jan. 17, 1997 do hereby state that under requirements of P.A. 74, Michigan P.A. of 1970, the corner points mentioned in lines 1 and 2 above were in conformance with regulations and rules therefore as required in the current manual of survey instructions of the United States Department of the Interior, Bureau of Land Management or by a decree of a Court of Law and/or that the corner points mentioned in lines 3, 4 and 5 above were in conformance with the rules of the Michigan Board of Land Surveyors or by a Decree of a Court of Law, established, re-established, monumented, recovered, found as expressed below:

NOTE: Not more than 2 corners, all in the same town and range, may be recorded on this certificate.

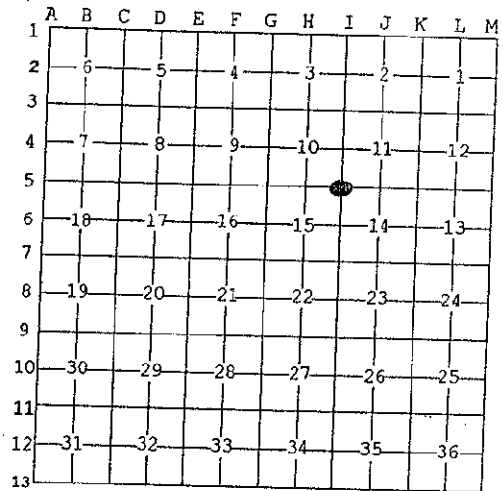

A. Description of original monument and accessories and/or subsequent restoration:

I-5	1830	GLO	Mullett	Set Post
	1943	Kent Co. Wit.		3/4" Iron
	1976	LCRC #990	Nederveld	3/4" Round Iron
	1980	LCRC #1479	Merdzinski	Set Kent County Monument
	1990	LCRC #5476	Starr	Kent County Monument

The position of this corner was previously approved by the Kent County Remonumentation Peer Group, monumented by John A. Merdzinski on 11-25-80 and was recorded per LCRC #1479

B. Description of corner evidence found and/or method applied in restoring or reestablishing corner:


I-5 Found standard Kent Co. Mon. (Harrison) per witnesses from above LCRC as set by John A. Merdzinski in place of the 3/4" Iron he found. Said Iron checks with Kent Co. Wit. and LCRC #990.

<u>LCRC #1479</u>	Nail & tag 6" Oak	S80°W 27.90'	Nail & tag 8" Oak	<u>LCRC #5476</u>
	Nail & tag 16" Maple	S20°E 14.52'	S40°W 14.25'	same witnesses
	Nail & tag 16" Oak	S65°E 22.50'		as LCRC #1479
	Nail & tag 8" Oak	N50°E 14.60'	Fence line to N.	
	Nail & tag 16" Tw. Oak	N20°E 45.53'		

The selected location is accepted by me and is generally accepted by professional surveyors as the best available evidence of the position of the original corner.

C. Description of monument for corner and accessories established to perpetuate locating the position of the corner:

I-5	Standard Kent County Monument	
	Nail & KC Remon. tag N. side 10" Oak	S80°W 27.98'
	Nail & KC Remon. tag NE side 14" Oak	S40°W 14.40'
	Nail & KC Remon. tag NE side 24" Oak	S65°E 22.27'
	Nail & KC Remon. tag N. side 10" Oak	N50°E 14.61'
	Nail & KC Remon. tag W. side Tw. 20" Oak	N20°E 45.40'
	On Fence line North	

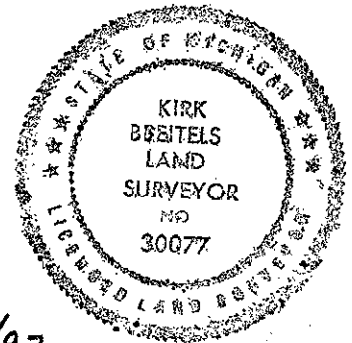

Signed by Kirk Breitels
Surveyor's Michigan License No. 30077

Date 3/27/97

P.A. 345 1990 KENT COUNTY

PEER APPROVED 3/27/97

CHAIRMAN Henry Kubers