

**SURVEY & REMONUMENTATION**

MAR 03 1998


KENT COUNTY REMONUMENTATION

**LAND CORNER RECORDATION CERTIFICATE**  
Filing Requirement of Act 74, Mich. P.A. 1970

For corners in **SECTION**  
**KENT COUNTY**  
(County)

Located In:	Corner Code #
T 6N R 9W	I-7
T R	
T R	
T R	
S T R	
S T R	
S T R	
S T R	

- 1. Public Land Survey
- 2. Property Controlling in Section
- 3. Miscellaneous Property in Sec.

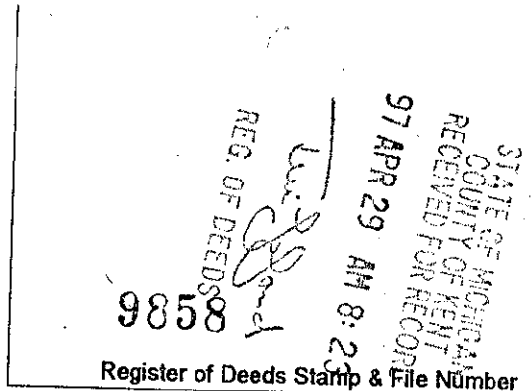

4. Lot No. \_\_\_\_\_, Recorded Plat \_\_\_\_\_  
5. Private Claims \_\_\_\_\_

I, Kirk Breitels, in a field survey on Jan. 17, 1997 do hereby state that under requirements of P.A. 74, Michigan P.A. of 1970, the corner points mentioned in lines 1 and 2 above were in conformance with regulations and rules therefore as required in the current manual of survey instructions of the United States Department of the Interior, Bureau of Land Management or by a decree of a Court of Law and /or that the corner points mentioned in lines 3, 4 and 5 above were in conformance with the rules of the Michigan Board of Land Surveyors or by a Decree of a Court of Law; established, re-established, monumented, recovered, found as expressed below:

A	B	C	D	E	F	G	H	I	J	K	L	M
1												
2	6	5	4	3	2	1						
3												
4	7	8	9	10	11	12						
5												
6	18	17	16	15	14	13						
7												
8	19	20	21	22	23	24						
9												
10	30	29	28	27	26	25						
11												
12	31	32	33	34	35	36						
13												

NOTE: Not more than 2 corners, all in the same town and range, may be recorded on this certificate.

A. Description of original monument and accessories and/or subsequent restoration:

I-7	1830	GLO	Mullett	Set Post
		Kent Co. Wit.		Monument
	1972	LCRC #169	Bonnema	Monument
	1978	LCRC #1211	Jonker	Concrete Monument
	1981	LCRC #2226	Jonker	Set Kent County Monument
	1990	LCRC #5478	Starr	Kent County Monument

The position of this corner was previously approved by the Kent County Remonumentation Peer Group, monumented by Robert J. Jonker on 10-30-81 and was recorded per LCRC #2226.

B. Description of corner evidence found and/or method applied in restoring or reestablishing corner:

I-7 Found standard Kent Co. Mon. (Harrison) per witnesses from above LCRC as set by Robert J. Jonker in place of the Concrete Monument he found. Said Concrete Monument checks with Kent Co. Wit. and LCRC's #169 & #2226.

LCRC #2226	LCRC #5478
Remon. tag 16" Hickory N90°E 11.51'	Nail & tag 16" Hickory N90°E 11.53'
Remon. tag 16" Hickory N90°W 2.72'	Nail & tag 16" Hickory N90°W 2.64'
Remon. tag 20" Hickory S27°E 26.36'	Nail & tag 20" Hickory S27°E 26.30'
Remon. tag 15" Oak N08°W 30.61'	Nail & tag 15" Oak N08°W 30.58'

The selected location is accepted by me and is generally accepted by professional surveyors as the best available evidence of the position of the original corner.

C. Description of monument for corner and accessories established to perpetuate locating the position of the corner:

I-7	Standard Kent County Monument
	Nail & KC Remon. tag N. side 18" Hickory N90°E 11.53'
	Nail & KC Remon. tag N. side 18" Hickory N90°W 2.68'
	Nail & KC Remon. tag NE side 24" Hickory S27°E 26.33'
	Nail & KC Remon. tag E. side 18" Oak N08°W 30.58'
	Fence corner to South & East is 2.5' West
	Fence corner to West is 36' South



Signed by Kirk Breitels  
Surveyor's Michigan License No. 30077

Date 3/27/97

P.A. 345 1990 KENT COUNTY  
PEER APPROVED 3/27/97  
CHAIRMAN Sam Kubes