

SURVEY & REMONUMENTATION

MAR 03 1998


KENT COUNTY REMONUMENTATION

LAND CORNER RECORDATION CERTIFICATE Filing Requirement of Act 74, Mich. P.A. 1970

For corners in **SECTION**
KENT COUNTY
(County)

Located In: Corner Code #

- | | | |
|------------------------------------|-----------|-----|
| 1. Public Land Survey | T 6N R 9W | I-8 |
| | T R | |
| | T R | |
| | T R | |
| 2. Property Controlling in Section | S T R | |
| | S T R | |
| 3. Miscellaneous Property in Sec. | S T R | |
| | S T R | |

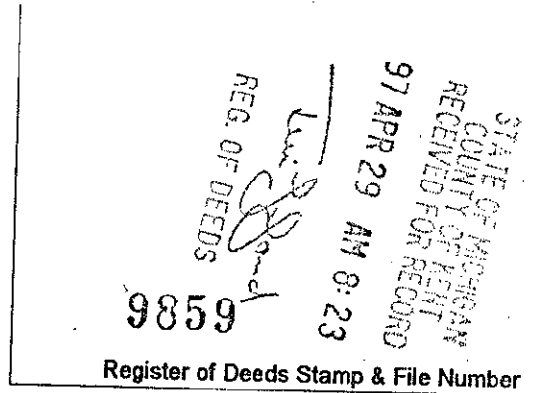

4. Lot No. _____, Recorded Plat _____
5. Private Claims _____

I, Kirk Breitels, in a field survey on Jan. 31, 1997 do hereby state that under requirements of P.A. 74, Michigan P.A. of 1970, the corner points mentioned in lines 1 and 2 above were in conformance with regulations and rules therefore as required in the current manual of survey instructions of the United States Department of the Interior, Bureau of Land Management or by a decree of a Court of Law and /or that the corner points mentioned in lines 3, 4 and 5 above were in conformance with the rules of the Michigan Board of Land Surveyors or by a Decree of a Court of Law; established, re-established, monumented, recovered, found as expressed below:

NOTE: Not more than 2 corners, all in the same town and range, may be recorded on this certificate.

| A | B | C | D | E | F | G | H | I | J | K | L | M |
|----|----|----|----|----|----|----|---|---|---|---|---|---|
| 1 | | | | | | | | | | | | |
| 2 | 6 | 5 | 4 | 3 | 2 | 1 | | | | | | |
| 3 | | | | | | | | | | | | |
| 4 | 7 | 8 | 9 | 10 | 11 | 12 | | | | | | |
| 5 | | | | | | | | | | | | |
| 6 | 18 | 17 | 16 | 15 | 14 | 13 | | | | | | |
| 7 | | | | | | | | | | | | |
| 8 | 19 | 20 | 21 | 22 | 23 | 24 | | | | | | |
| 9 | | | | | | | | | | | | |
| 10 | 30 | 29 | 28 | 27 | 26 | 25 | | | | | | |
| 11 | | | | | | | | | | | | |
| 12 | 31 | 32 | 33 | 34 | 35 | 36 | | | | | | |
| 13 | | | | | | | | | | | | |

A. Description of original monument and accessories and/or subsequent restoration:

| | | | | |
|-----|------|------------|--------------|--------------------------|
| I-8 | 1830 | GLO | Mullett | Set Post |
| | 1983 | LCRC #3466 | Bonnema | "T" Iron |
| | 1983 | LCRC #3549 | Chettleburgh | Set Kent County Monument |
| | 1990 | LCRC #5479 | Starr | Kent County Monument |

The position of this corner was previously approved by the Kent County Remonumentation Peer Group, monumented by Thomas Chettleburgh on 10/11/83 and was recorded per LCRC #3549.

B. Description of corner evidence found and/or method applied in restoring or reestablishing corner:

I-8 Found standard Kent Co. Mon. (Harrison) per witnesses from above LCRC as set by Thomas Chettleburgh in place of the "T" Iron he found. "T" Iron checks LCRC #3466.

| | | |
|-------------------|------------|-----------------------------------|
| <u>LCRC #3549</u> | | <u>LCRC #5479</u> |
| Nail 25" Maple | ENE 44.81' | Nail & tag 26" Maple N80°E 44.94' |
| Spike 14" Apple | SE 38.38' | Nail & tag 16" Apple S35°E 38.38' |
| Nail 16" Elm | S 82.80' | Nail & tag 20" Maple N80°W 39.77' |
| Nail 18" Maple | W 39.76' | Nail & tag 26" Cherry N25°W 5.15' |
| Nail 24" Cherry | NNW 5.12' | Nail & tag 24" Maple North 31.65' |
| Nail 21" Maple | NNW 31.63' | |

The selected location is accepted by me and is generally accepted by professional surveyors as the best available evidence of the position of the original corner.

C. Description of monument for corner and accessories established to perpetuate locating the position of the corner:

I-8 Standard Kent County Monument

| | |
|-----------------------------------------|--------------|
| Nail & KC Remon. tag S. side 30" Maple | N80°E 45.00' |
| Nail & KC Remon. tag NE side 18" Apple | S35°E 38.41' |
| Nail & KC Remon. tag S. side 26" Maple | N80°W 39.68' |
| Nail & KC Remon. tag SW side 30" Cherry | N25°W 5.06' |
| Nail & KC Remon. tag E. side 28" Maple | North 31.65' |

On fence line North & on tree row South - East - West



Signed by Kirk Breitels
Surveyor's Michigan License No. 30077

Date 3/27/97

P.A. 345 1990 KENT COUNTY

PEER APPROVED 3/27/97
CHAIRMAN [Signature]