

**SURVEY & REMONUMENTATION**

**MAR 03 1998**

**KENT COUNTY REMONUMENTATION**

**SECTION**

**LAND CORNER RECORDATION CERTIFICATE**  
Filing Requirement of Act 74, Mich. P.A. 1970

For corners in  
**KENT COUNTY**

Located In:	Corner Code #
1. Public Land Survey	T6N R9W I-13
	T___ R___
	T___ R___
	T___ R___
	T___ R___
2. Property Controlling in Section	S___ T___ R___
	S___ T___ R___
3. Miscellaneous Property in Sec.	S___ T___ R___
	S___ T___ R___

STATE OF MICHIGAN  
 COUNTY OF KENT  
 RECEIVED FOR RECORD  
 97 JUN -3 AM 8:11  
 REG. OF DEEDS  
*Luis Bond*

**9996**

Register of Deeds Stamp & File Number

4. Lot No. \_\_\_\_\_, Recorded Plat \_\_\_\_\_  
 5. Private Claims \_\_\_\_\_

I, Kirk Breitels, in a field survey on Apr. 14, 1997 do hereby state that under requirements of P.A. 74, Michigan P.A. of 1970, the corner points mentioned in lines 1 and 2 above were in conformance with regulations and rules therefore as required in the current manual of survey instructions of the United States Department of the Interior, Bureau of Land Management or by a decree of a Court of Law and/or that the corner points mentioned in lines 3, 4 and 5 above were in conformance with the rules of the Michigan Board of Land Surveyors or by a Decree of a Court of Law; established, re-established, monumented, recovered, found as expressed below:

NOTE: Not more than 2 corners, all in the same town and range, may be recorded on this certificate.

	A	B	C	D	E	F	G	H	I	J	K	L	M
1													
2	6		5		4		3		2		1		
3													
4	7		8		9		10		11		12		
5													
6	18		17		16		15		14		13		
7													
8	19		20		21		22		23		24		
9													
10	30		29		28		27		26		25		
11													
12	31		32		33		34		35		36		
13													

A. Description of original monument and accessories and/or subsequent restoration:

I-13	1830	GLO	Mullett	Set Post
		Kent Co. Wit.		No corner mentioned - 48.8' jog
	1982	LCRC #2888	Jonker	3/4" Iron
	1982	LCRC #3090	Jonker	Set Kent County Monument
	1990	LCRC #5484	Starr	Kent County Monument

The position of this corner was previously approved by the Kent County Remonumentation Peer Group, monumented by Robert J. Jonker on 9/17/82 and was recorded per LCRC #3090

B. Description of corner evidence found and/or method applied in restoring or reestablishing corner:


I-13 Found BROKEN standard Kent Co. Mon. (Harrison) per witnesses from above LCRC as set by Robert J. Jonker in place of the 3/4" Iron he found. Said Iron checks with jog per Kent Co. Wit. and LCRC #2888. Reset Kent Co. Mon. per remaining witnesses.

LCRC #3090	LCRC #5484
Remon. tag 8" Elm N00°E 30.55'	Nail & tag 8" Elm N00°E 30.60'
1 1/2" Iron East 48.8'	1 1/2" Iron East 48.8'
Chiseled "X" culv. N50°W 32.2'	C/L stop sign post S50°E 84.70'
C/L stop sign post S50°E 84.7'	

The selected location is accepted by me and is generally accepted by professional surveyors as the best available evidence of the position of the original corner.

C. Description of monument for corner and accessories established to perpetuate locating the position of the corner:

I-13 Standard Kent County Monument	
Nail & KC Remon. tag E. side 15" Elm	N00°E 30.60'
1 1/2" Iron Pipe	East 48.80'
C/L stop sign post (diff. from prev.)	S50°E 83.5'
Nail & KC Remon. tag SW side wood fence post	N40°W 48.56'
Capped Rerod (Prien & Newhoff)	North 33.00'

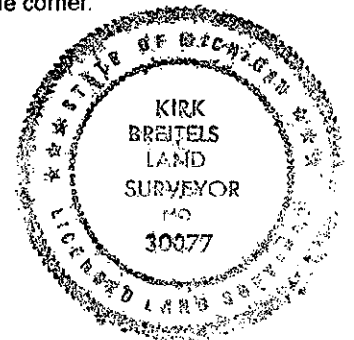

Signed by *Kirk Breitels*  
 Surveyor's Michigan License No. 30077

Date 5/22/97

P.A. 345 1990 KENT COUNTY  
 PEER APPROVED 5/22/97  
 CHAIRMAN *Harry Stuber*