

SURVEY & REMONUMENTATION

MAR 03 1998

KENT COUNTY REMONUMENTATION

SECTION

LAND CORNER RECORDATION CERTIFICATE
Filing Requirement of Act 74, Mich. P.A. 1970

STATE OF MICHIGAN
COUNTY OF KENT
RECEIVED FOR RECORD
97 OCT 14 AM 10:01
REG. OF DEEDS
David Bond

For corners in
KENT COUNTY

(County)

Located In:	Corner Code #
T6N R9W	J-6
T R	
T R	
T R	
T R	
S T R	
S T R	
S T R	
S T R	

1. Public Land Survey

2. Property Controlling in Section

3. Miscellaneous Property in Sec.

4. Lot No. _____, Recorded Plat _____
5. Private Claims _____

I, Kirk Breitels, in a field survey on July 1, 1997 do hereby state that under requirements of P.A. 74, Michigan P.A. of 1970, the corner points mentioned in lines 1 and 2 above were in conformance with regulations and rules therefore as required in the current manual of survey instructions of the United States Department of the Interior, Bureau of Land Management or by a decree of a Court of Law and for that the corner points mentioned in lines 3, 4 and 5 above were in conformance with the rules of the Michigan Board of Land Surveyors or by a Decree of a Court of Law, established, re-established, monumented, recovered, found as expressed below:

NOTE: Not more than 2 corners, all in the same town and range, may be recorded on this certificate.

	A	B	C	D	E	F	G	H	I	J	K	L	M
1													
2	6	5	4	3	2	1							
3													
4	7	8	9	10	11	12							
5													
6	18	17	16	15	14	13							
7													
8	19	20	21	22	23	24							
9													
10	30	29	28	27	26	25							
11													
12	31	32	33	34	35	36							
13													

10043

Register of Deeds Stamp & File Number

A. Description of original monument and accessories and/or subsequent restoration:

- J-6 1830---GLO---Not Set
- 1912-69---Williams & Works---Found/used large Iron
10" Oak ENE 29.6' 8" Oak NE 47.0' 6" Oak SSW 31.9' 8" Oak SE 85.15'
- 1971---Kent Co. Wit.---"T" Iron
9" Sass. S 43.07' CP Pole ESE 33.19' 18" Oak NE 47.79'
- 1973-86---Williams & Works---Found "T" Iron (agrees with prev. wit.)
- 1972---LCRC #169---Bonnema---"T" Iron
P. Pole E 33.17' 16" Oak NE 47.77' 8" Sass. SSE 43.0' Fc. Post SW 17.6'
- 1991---LCRC #5773---Chettleburgh---"T" Iron
5" Oak S88°E 45.57' P. Pole S70°E 33.08' 16" Oak S23°E 81.12'
9" Sassafras S12°E 42.84' 10" Pine S32°W 59.13'

B. Description of corner evidence found and/or method applied in restoring or reestablishing corner:


- J-6 Found "T" Iron (10" deep) next to Iron Pipe (18" deep) per the following witnesses:
- C/L 15" Oak SE 85'± Fd. nail in 18" Oak S23°E 81.12'
- C/L 10" Oak S88°E 45'± Fd. nail in 12" Sassafras S12°E 42.86'
- Fd. nail in P. Pole S70°E 33.08' Fd. nail in 18" Pine S32°W 59.13'

The "T" Iron is 3.6' E. and 13.0' N. from intersection of 1/4 lines and agrees with measurements of others.

The "T" Iron is accepted by me and is generally accepted by professional surveyors as the best available evidence of the position of the corner.

C. Description of monument for corner and accessories established to perpetuate locating the position of the corner:

- J-6 Set Standard Kent Co. Monument (Harrison) in place of the "T" Iron and Iron Pipe
- Nail & KC Remon. tag N. side 10" Oak S88°E 45.54'
- Nail & KC Remon. tag S. side P. Pole S70°E 33.08'
- Nail & KC Remon. tag E. side 18" Oak S23°E 81.12'
- Nail & KC Remon. tag W. side 12" Sassafras S12°E 42.86'
- Nail & KC Remon. tag NW side 18" Pine S32°W 59.13'
- Iron Pipe - East 52.94'

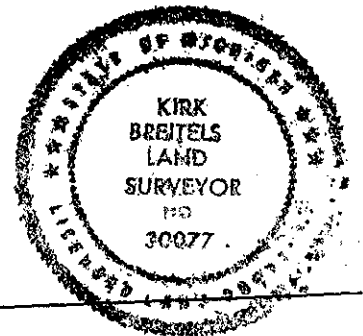

Signed by *Kirk Breitels*
Surveyor's Michigan License No. 30077
P.A. 345 1990 KENT COUNTY

Date 8/28/97

PEER APPROVED 7/24/97
CHAIRMAN *Stan Hubert*