

**SURVEY & REMONUMENTATION**

**MAR 03 1998**

**KENT COUNTY REMONUMENTATION**

**SECTION**

**LAND CORNER RECORDATION CERTIFICATE**  
Filing Requirement of Act 74, Mich. P.A. 1970

STATE OF MICHIGAN  
COUNTY OF KENT  
RECEIVED FOR RECORD  
97 APR 29 AM 8:24  
REG. OF DEEDS  
*Lucy Bond*

**9867**

Register of Deeds Stamp & File Number

For corners in  
KENT COUNTY  
(County)

Located In:	Corner Code #
T6N R9W	J-7
T R	
T R	
T R	
T R	
S T R	
S T R	
S T R	
S T R	

1. Public Land Survey

2. Property Controlling in Section

3. Miscellaneous Property in Sec.

4. Lot No. \_\_\_\_\_, Recorded Plat \_\_\_\_\_  
5. Private Claims \_\_\_\_\_

I, Kirk Breitels, in a field survey on Jan. 3, 1997 do hereby state that under requirements of P.A. 74, Michigan P.A. of 1970, the corner points mentioned in lines 1 and 2 above were in conformance with regulations and rules therefore as required in the current manual of survey instructions of the United States Department of the Interior, Bureau of Land Management or by a decree of a Court of Law and/or that the corner points mentioned in lines 3, 4 and 5 above were in conformance with the rules of the Michigan Board of Land Surveyors or by a Decree of a Court of Law; established, re-established, monumented, recovered, found as expressed below:

NOTE: Not more than 2 corners, all in the same town and range, may be recorded on this certificate.

	A	B	C	D	E	F	G	H	I	J	K	L	M
1													
2	6		5		4		3		2		1		
3													
4	7		8		9		10		11		12		
5													
6	18		17		16		15		14		13		
7													
8	19		20		21		22		23		24		
9													
10	30		29		28		27		26		25		
11													
12	31		32		33		34		35		36		
13													

A. Description of original monument and accessories and/or subsequent restoration:

J-7	1830	GLO	Mullett	Set Post Monument
		Kent Co. Wit.		
	1972	LCRC #169	Bonnema	Monument
	1981	LCRC #2227	Jonker	Set Kent County Monument
	1990	LCRC #5485	Starr	Kent County Monument

The position of this corner was previously approved by the Kent County Remonumentation Peer Group, monumented by Robert J. Jonker on 10/28/81 and was recorded per LCRC #2227


B. Description of corner evidence found and/or method applied in restoring or reestablishing corner:  
J-7 Found standard Kent Co. Mon. (Harrison) per witnesses from above LCRC as set by Robert J. Jonker in place of the 1" Iron in Concrete Monument he found. Said Iron in Conc. Mon. checks with Kent Co. Wit. and LCRC #169.

LCRC #2227	LCRC #5485		
Remon. tag 16" x 18" Ash	S04°W 49.94'	Nail & tag 16" x 18" Walnut	S04°W 49.87'
Remon. tag 10" Walnut	S40°E 45.87'	Nail & tag 10" Walnut	S40°E 45.88'
Remon. tag 9" Walnut	N50°E 28.23'	Nail & tag 12" Walnut	N26°W 23.91'
Remon. tag 12" Walnut	N26°W 23.91'	Nail & tag 15" Walnut	S65°W 45.84'
Remon. tag 15" Walnut	S65°W 45.92'	Nail & tag 10" Walnut	N75°E 60.62'

The selected location is accepted by me and is generally accepted by professional surveyors as the best available evidence of the position of the original corner.

C. Description of monument for corner and accessories established to perpetuate locating the position of the corner:

J-7 Standard Kent County Monument	
Nail & KC Remon. tag E. side 20" & 24" Walnut	S04°W 49.95'
Nail & KC Remon. tag SW side 16" Walnut	S40°E 45.88'
Nail & KC Remon. tag W. side 16" Walnut	N26°W 23.97'
Nail & KC Remon. tag SE side 18" Walnut	S65°W 45.89'
Nail & KC Remon. tag S. side 12" Walnut	N75°E 60.62'
On fence & tree line South	
On tree line North	

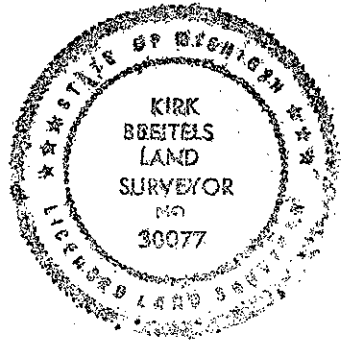

Signed by *Kirk Breitels*  
Surveyor's Michigan License No. 30077  
P.A. 345 1990 KENT COUNTY

Date 3/27/97

PEER APPROVED 3/27/97  
CHAIRMAN *Harry Johnson*