

SECTION

KENT COUNTY REMONUMENTATION

LAND CORNER RECORDATION CERTIFICATE
Filing Requirement of Act 74, Mich. P.A. 1970

For corners in
KENT COUNTY
(County)

Located In:	Corner Code #
T6N R 9W	J-11
T R	
T R	
T R	
T R	
S T R	
S T R	
S T R	
S T R	

1. Public Land Survey

2. Property Controlling in Section

3. Miscellaneous Property in Sec.

4. Lot No. _____, Recorded Plat _____

5. Private Claims _____

STATE OF MICHIGAN
COUNTY OF KENT
RECEIVED FOR RECORD
97 APR 29 AM 8:24
REG. OF DEEDS
Lucy Bond

9869

Register of Deeds Stamp & File Number

I, Kirk Breitels, in a field survey on Jan. 16, 1997 do hereby state that under requirements of P.A. 74, Michigan P.A. of 1970, the corner points mentioned in lines 1 and 2 above were in conformance with regulations and rules therefore as required in the current manual of survey instructions of the United States Department of the Interior, Bureau of Land Management or by a decree of a Court of Law and /or that the corner points mentioned in lines 3, 4 and 5 above were in conformance with the rules of the Michigan Board of Land Surveyors or by a Decree of a Court of Law; established, re-established, monumented, recovered, found as expressed below.

NOTE: Not more than 2 corners, all in the same town and range, may be recorded on this certificate.

A	B	C	D	E	F	G	H	I	J	K	L	M
1												
2	6	5	4	3	2	1						
3												
4	7	8	9	10	11	12						
5												
6	18	17	16	15	14	13						
7												
8	19	20	21	22	23	24						
9												
10	30	29	28	27	26	25						
11												
12	31	32	33	34	35	36						
13												

A. Description of original monument and accessories and/or subsequent restoration:

J-11	1830	GLO	Mullett	Set Post
	1959	Kent Co. Wit.		1/2" Iron
	1983	LCRC #3548	Chettleburgh	Set Kent County Monument
	1990	LCRC #5487	Starr	Kent County Monument

The position of this corner was previously approved by the Kent County Remonumentation Peer Group, monumented by Thomas Chettleburgh on 10-11-83 and recorded per LCRC #3548

B. Description of corner evidence found and/or method applied in restoring or reestablishing corner:

J-11 Found standard Kent Co. Mon. (Harrison) per witnesses from above LCRC as set by Thomas Chettleburgh in place of the "T" Iron he found. Said "T" Iron checks with Kent Co. measurements and measurements of others.

LCRC #3548

LCRC #5487


Nail in 16" Spruce	NNE	64.12'	Nail & tag 16" Spruce	N25°E	64.12'
Nail in 12" Elm	ESE	77.21'	Nail & tag 12" Elm	S70°E	77.21'
Nail in P. Pole	SE	50.96'	Nail & tag P. Pole	S20°E	50.96'
Nail in 25" Ash	SW	75.98'	Nail & tag 25" Ash	S80°W	75.98'
Nail in P. Pole	NNW	41.56'	Nail & tag P. Pole	North	41.56'

The selected location is accepted by me and is generally accepted by professional surveyors as the best available evidence of the position of the original corner.

C. Description of monument for corner and accessories established to perpetuate locating the position of the corner:

J-11 Standard Kent County Monument

Nail & KC Remon. tag E. side 22" Spruce	N25°E	64.21'
Nail & KC Remon. tag NE side 14" Elm	S70°E	77.27'
Nail & KC Remon. tag NE side P. Pole	S20°E	51.01'
Nail & KC Remon. tag W. side P. Pole	North	41.56'
Nail & KC Remon. tag N. side 20" Elm	S80°W	60.02'
C/L E-W Bit. road is 3.6' North		
C/L grav. dr. South is 8' West		
North and South power line is 2' West		

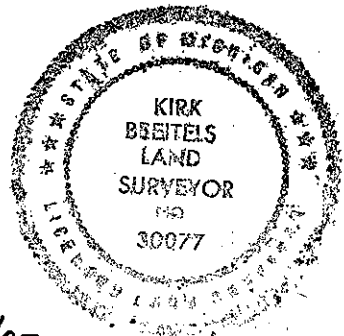

Signed by *Kirk Breitels*
Surveyor's Michigan License No. 30077

Date 3/27/97

P.A. 345 1990 KENT COUNTY

PEER APPROVED 3/27/97

CHAIRMAN *Sam Huber*