

SURVEY & REMONUMENTATION

MAR 03 1998

KENT COUNTY REMONUMENTATION

LAND CORNER RECORDATION CERTIFICATE Filing Requirement of Act 74, Mich. P.A. 1970.

For corners in **SECTION**
KENT COUNTY
(County)

	Located In:	Corner Code #
1. Public Land Survey	T 6N R 9W	J-13
	T _____ R _____	_____
	T _____ R _____	_____
	T _____ R _____	_____
2. Property Controlling in Section	S _____ T _____ R _____	_____
	S _____ T _____ R _____	_____
3. Miscellaneous Property in Sec.	S _____ T _____ R _____	_____
	S _____ T _____ R _____	_____

STATE OF MICHIGAN
 COUNTY OF KENT
 RECEIVED FOR RECORD
 97 APR 29 AM 8:24
 REG. OF DEEDS
Eric Bond

9870

Register of Deeds Stamp & File Number

4. Lot No. _____, Recorded Plat _____
 5. Private Claims _____

	A	B	C	D	E	F	G	H	I	J	K	L	M
1													
2	6	5	4	3	2	1							
3													
4	7	8	9	10	11	12							
5													
6	18	17	16	15	14	13							
7													
8	19	20	21	22	23	24							
9													
10	30	29	28	27	26	25							
11													
12	31	32	33	34	35	36							
13													

I, Kirk Breitels, in a field survey on Jan. 7, 1997 do hereby state that under requirements of P.A. 74, Michigan P.A. of 1970, the corner points mentioned in lines 1 and 2 above were in conformance with regulations and rules therefore as required in the current manual of survey instructions of the United States Department of the Interior, Bureau of Land Management or by a decree of a Court of Law and /or that the corner points mentioned in lines 3, 4 and 5 above were in conformance with the rules of the Michigan Board of Land Surveyors or by a Decree of a Court of Law; established, re-established, monumented, recovered, found as expressed below:

NOTE: Not more than 2 corners, all in the same town and range, may be recorded on this certificate.

A. Description of original monument and accessories and/or subsequent restoration:

J-13	1830	GLO	Mullett	Set Post
	1984	LCRC #4050	Meyer	1" Crimped Iron
	1985	LCRC #4107	Jonker	Set Kent County Monument
	1990	LCRC #5488	Starr	Kent County Monument

The position of this corner was previously approved by the Kent County Remonumentation Peer Group, monumented by Robert J. Jonker on 1/25/81 and was recorded per LCRC #4107.

B. Description of corner evidence found and/or method applied in restoring or reestablishing corner:

J-13 Found standard Kent Co. Mon. (Harrison) per witnesses from above LCRC as set by Robert J. Jonker in place of the 1" Crimped Iron he found. Said Iron checks with LCRC #4050.

<u>LCRC #4107</u>				<u>LCRC #5488</u>			
KC Mon. (J-1, 5-9)	East	20.22'	KC Mon. (J-1, 5-9)	East	20.22'		
Remon. tag 12" Ash	S50°W	39.78'	Nail & tag 12" Ash	S50°W	39.66'		
Nail & tag 12" Oak	N65°W	58.30'	Nail & tag 12" Oak	N65°W	58.07'		
Remon. tag P. Pole	S35°E	50.46'	Nail & tag P. Pole	S35°E	50.46'		


The selected location is accepted by me and is generally accepted by professional surveyors as the best available evidence of the position of the original corner.

C. Description of monument for corner and accessories established to perpetuate locating the position of the corner:

J-13 Standard Kent County Monument

Kent Co. Mon. (J-1, T5N, R9W)	East	20.22'
Nail & KC Remon. tag N. side 16" Ash	S50°W	39.57'
Nail & KC Remon. tag S. side 16" Oak	N65°W	58.05'
Nail & KC Remon. tag W. side P. Pole	S35°E	50.46'

On C/L East and West gravel road
 Fence line South is 24' West

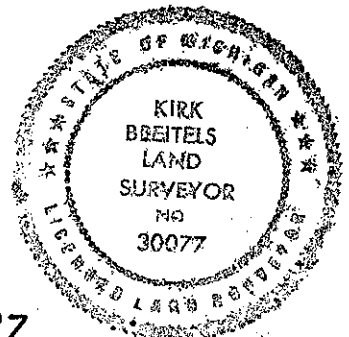

Signed by *Kirk Breitels*
 Surveyor's Michigan License No. 30077
 P.A. 345 1990 KENT COUNTY
 PEER APPROVED 3/27/97
 CHAIRMAN *Harry Hubert*

Date 3/27/97