

SURVEY & REMONUMENTATION

MAR 03 1998

KENT COUNTY REMONUMENTATION

LAND CORNER RECORDATION CERTIFICATE
Filing Requirement of Act 74, Mich. P.A. 1970

SECTION

For corners in

KENT COUNTY

(County)

Located In:

Corner Code #

1. Public Land Survey	T <u>6N</u>	R <u>9W</u>	<u>K-5</u>
	T _____	R _____	_____
	T _____	R _____	_____
	T _____	R _____	_____
2. Property Controlling in Section	S _____	T _____	R _____
	S _____	T _____	R _____
3. Miscellaneous Property in Sec.	S _____	T _____	R _____
	S _____	T _____	R _____

STATE OF MICHIGAN
 COUNTY OF KENT
 RECEIVED FOR RECORD
 97 APR 29 AM 8:25
 REG. OF DEEDS
W. J. Starr

9874

Register of Deeds Stamp & File Number

4. Lot No. _____, Recorded Plat _____
 5. Private Claims _____

I, Kirk Breitels, in a field survey on Jan. 16, 1997 do hereby state that under requirements of P.A. 74, Michigan P.A. of 1970, the corner points mentioned in lines 1 and 2 above were in conformance with regulations and rules therefore as required in the current manual of survey instructions of the United States Department of the Interior, Bureau of Land Management or by a decree of a Court of Law and/or that the corner points mentioned in lines 3, 4 and 5 above were in conformance with the rules of the Michigan Board of Land Surveyors or by a Decree of a Court of Law; established, re-established, monumented, recovered, found as expressed below:

1	A	B	C	D	E	F	G	H	I	J	K	L	M
2	6		5		4		3		2		1		
3													
4	7		8		9		10		11		12		
5													
6	10		17		16		15		14		13		
7													
8	19		20		21		22		23		24		
9													
10	30		29		28		27		26		25		
11													
12	31		32		33		34		35		36		
13													

NOTE: Not more than 2 corners, all in the same town and range, may be recorded on this certificate.

A. Description of original monument and accessories and/or subsequent restoration:

K-5	1830	GLO	Mullett	Set Post
	1939	Kent Co. Wit.		Concrete Monument
	1978	LCRC #1200	Jonker	Concrete Monument
	1981	LCRC #2230	Jonker	Set Kent County Monument
	1990	LCRC #5441	Starr	Kent County Monument

The position of this corner was previously approved by the Kent County Remonumentation Peer Group, monumented by Robert J. Jonker on 10-28-81 and was recorded per LCRC #2230.

B. Description of corner evidence found and/or method applied in restoring or reestablishing corner:

K-5 Found standard Kent Co. Mon. (Harrison) per witnesses from above LCRC as set by Robert J. Jonker in place of the Concrete Monument he found. Said Concrete Monument checks with Kent Co. Wit. and LCRC #1200.

LCRC #2230
 Remon. tag P. Pole N11°W 72.08'
 Remon. tag 18" Willow N10°E 40.53'
 Remon. tag 10" Willow N50°E 56.75'
 Remon. tag 14" Tw. Cher. S22°E 63.92'
 Remon. tag P. Pole S54°W 45.59'


LCRC #5441
 same witnesses as LCRC #2230

The selected location is accepted by me and is generally accepted by professional surveyors as the best available evidence of the position of the original corner.

C. Description of monument for corner and accessories established to perpetuate locating the position of the corner:

K-5 Standard Kent County Monument

Nail & KC Remon. tag E. side P. Pole	N11°W	72.11'
Nail & KC Remon. tag W. side 30" Willow	N10°E	40.46'
Nail & KC Remon. tag E. side 24" Willow	N50°E	56.84'
Nail & KC Remon. tag W. side Tw. 18" Cherry	S22°E	63.94'
Nail & KC Remon. tag NW side P. Pole	S54°W	45.56'
On C/L of East & West bit. road		
C/L of gravel road South is 2' East, On tree row North		

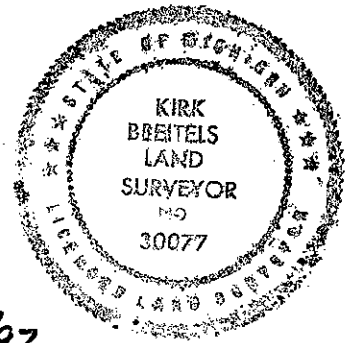

Signed by *Kirk Breitels*
 Surveyor's Michigan License No. 30077
 P.A. 345 1990 KENT COUNTY
 PEER APPROVED 3/27/97
 CHAIRMAN *Harry Hubert*

Date 3/27/97