

**SURVEY & REMONUMENTATION**

**MAR 03 1998**

**KENT COUNTY REMONUMENTATION**

**LAND CORNER RECORDATION CERTIFICATE**  
Filing Requirement of Act 74, Mich. P.A. 1970

REG. OF DEEDS  
97 APR 29 AM 8:26  
STATE OF MICHIGAN  
COUNTY OF KENT  
RECEIVED FOR RECORD

For corners in **SECTION**

<b>KENT COUNTY</b> (County)	Located In:	Corner Code #
1. Public Land Survey	T 6N R 9W	K-9
	T R	
	T R	
	T R	
2. Property Controlling in Section	S T R	
	S T R	
3. Miscellaneous Property in Sec.	S T R	
	S T R	

9878

Register of Deeds Stamp & File Number

4. Lot No. \_\_\_\_\_, Recorded Plat \_\_\_\_\_  
5. Private Claims \_\_\_\_\_

1	A	B	C	D	E	F	G	H	I	J	K	L	M
2	6		5		4		3		2		1		
3													
4	7		8		9		10		11		12		
5													
6	10		17		16		15		14		13		
7													
8	19		20		21		22		23		24		
9													
10	30		29		28		27		26		25		
11													
12	31		32		33		34		35		36		
13													

I, Kirk Breitels, in a field survey on Jan. 16, 1997 do hereby state that under requirements of P.A. 74, Michigan P.A. of 1970, the corner points mentioned in lines 1 and 2 above were in conformance with regulations and rules therefore as required in the current manual of survey instructions of the United States Department of the Interior, Bureau of Land Management or by a decree of a Court of Law and/or that the corner points mentioned in lines 3, 4 and 5 above were in conformance with the rules of the Michigan Board of Land Surveyors or by a Decree of a Court of Law; established, re-established, monumented, recovered, found as expressed below:

NOTE: Not more than 2 corners, all in the same town and range, may be recorded on this certificate.

A. Description of original monument and accessories and/or subsequent restoration:

K-9	1830	GLO	Mullett	Set Post
		Kent Co. Wit.		Stone
	1974	LCRC #633	Spicer	Concrete Nail
	1982	LCRC #2725	Merdzinski	Set Kent County Monument
	1990	LCRC #5445	Starr	Kent County Monument

The position of this corner was previously approved by the Kent County Remonumentation Peer Group, monumented by John A. Merdzinski on 3-26-82 and was recorded per LCRC #2725

B. Description of corner evidence found and/or method applied in restoring or reestablishing corner:


K-9 Found standard Kent Co. Mon. (Harrison) per witnesses from above LCRC as set by John A. Merdzinski in place of the Concrete Spike he found. Said Concrete Spike checks with Kent Co. Wit. and LCRC #633.

LCRC #2725	LCRC #5445
Nail & tag 24" Walnut S70°W 82.59'	Nail & tag 24" Walnut S70°W 82.59'
Nail & tag 30" Walnut N25°W 91.93'	Nail & tag 30" Walnut N25°W 91.93'
Nail & tag 32" Walnut N70°W 127.08'	Nail & tag 32" Walnut N70°W 127.08'
C/L fence post S30°E 54.25'	Nail & tag 14" Elm S35°E 54.65'

The selected location is accepted by me and is generally accepted by professional surveyors as the best available evidence of the position of the original corner.

C. Description of monument for corner and accessories established to perpetuate locating the position of the corner:

K-9 Standard Kent County Monument	
Nail & KC Remon. tag N. side 28" Walnut	S70°W 82.59'
Nail & KC Remon. tag E. side 30" dead Walnut	N25°W 91.93'
Nail & KC Remon. tag S. side 36" Walnut	N70°W 127.15'
Nail & KC Remon. tag W. side 20" Elm	S35°E 57.41'
Tree and fence line running South is 11' West	
On C/L of East & West bit. road (Cascade)	
On C/L of gravel road North (Pratt Lake Rd.)	

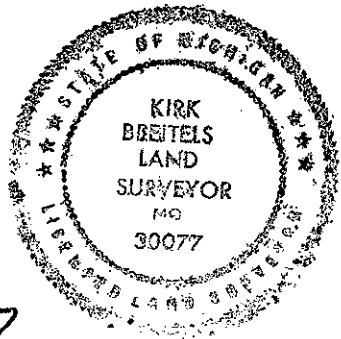

Signed by Kirk Breitels

Date 3/27/97

Surveyor's Michigan License No. 30077

P.A. 345 1990 KENT COUNTY  
PEER APPROVED 3/27/97  
CHAIRMAN [Signature]