

KENT COUNTY REMONUMENTATION

LAND CORNER RECORDATION CERTIFICATE
Filing Requirement of Act 74, Mich. P.A. 1970

For corners in

KENT COUNTY

(County)

Located In:

Corner Code #

1. Public Land Survey	T <u>6N</u> R <u>9W</u>	K-10
	T <u> </u> R <u> </u>	
	T <u> </u> R <u> </u>	
	T <u> </u> R <u> </u>	
2. Property Controlling in Section	S <u> </u> T <u> </u> R <u> </u>	
	S <u> </u> T <u> </u> R <u> </u>	
3. Miscellaneous Property in Sec.	S <u> </u> T <u> </u> R <u> </u>	
	S <u> </u> T <u> </u> R <u> </u>	

STATE OF MICHIGAN
COUNTY OF KENT
RECEIVED FOR RECORD
97 APR 29 AM 8:26
REG. OF DEEDS
Lucy Stand

9879

Register of Deeds Stamp & File Number

4. Lot No. _____, Recorded Plat _____
5. Private Claims _____

I, Kirk Breitels, in a field survey on Jan. 21, 19 97 do hereby state that under requirements of P.A. 74, Michigan P.A. of 1970, the corner points mentioned in lines 1 and 2 above were in conformance with regulations and rules therefore as required in the current manual of survey instructions of the United States Department of the Interior, Bureau of Land Management or by a decree of a Court of Law and /or that the corner points mentioned in lines 3, 4 and 5 above were in conformance with the rules of the Michigan Board of Land Surveyors or by a Decree of a Court of Law; established, re-established, monumented, recovered, found as expressed below:

NOTE: Not more than 2 corners, all in the same town and range, may be recorded on this certificate.

	A	B	C	D	E	F	G	H	I	J	K	L	M
1													
2	6		5		4		3		2		1		
3													
4	7		8		9		10		11		12		
5													
6	18		17		16		15		14		13		
7													
8	19		20		21		22		23		24		
9													
10	30		29		28		27		26		25		
11													
12	31		32		33		34		35		36		
13													

A. Description of original monument and accessories and/or subsequent restoration:

K-10 1830 GLO Mullett Set Post
1983 LCRC #3360 Bissell Set 1" Pipe w/cap at mid point of mile
1990 LCRC #5494 Bueche 1" Iron w/DNR cap in swamp

The position of this corner was previously approved by the Kent County Remonumentation Peer Group, presented by John C. Bueche on 5/24/90 and was recorded per LCRC #5494

B. Description of corner evidence found and/or method applied in restoring or reestablishing corner:


K-10 Found Iron Pipe with DNR cap in swamp per witnesses from above LCRC as recorded by John C. Bueche. Said Iron and cap checks with LCRC #5494

LCRC #5494
Nail & tag 8" Ash S43°E 4.48' Nail & tag 24" Ash S10°E 28.95'
Nail & tag 12" Maple N60°E 15.56' Nail & tag 6" Maple S40°W 28.85'
Nail & tag dbl. 16" Maple S80°E 25.55'
Nail & tag 18" Ash N45°W 20.15'
Nail & tag 8" Maple N90°W 29.35'

The selected location is accepted by me and is generally accepted by professional surveyors as the best available evidence of the position of the original corner.

C. Description of monument for corner and accessories established to perpetuate locating the position of the corner:

K-10 Standard Kent County Monument in swamp
Nail & KC Remon. tag W. side 12" Maple N60°E 15.56'
Nail & KC Remon. tag S. side dbl. 16" Maple S80°E 25.62'
Nail & KC Remon. tag W. side 18" Ash N45°W 20.15'
Nail & KC Remon. tag S. side 8" Maple N90°W 29.35'
Nail & KC Remon. tag E. side 24" Ash S10°E 28.95'
Nail & KC Remon. tag NW side 6" Maple S40°W 28.85'

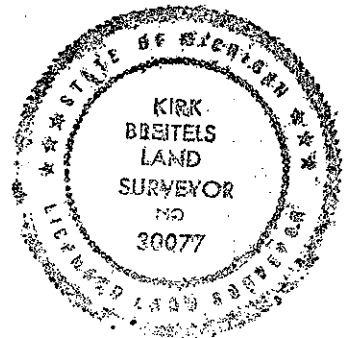

Signed by *Kirk Breitels* Date 3/27/97

Surveyor's Michigan License No. 30077

P.A. 345 1990 KENT COUNTY

PEER APPROVED 3/27/97

CHAIRMAN *Harry Huber*