SURVEY & REMONUMENTATION

MAR 0 3 1998

SECTION

KENT COUNTY REMONUMENTATION

STATE OF MICHIGAN
COUNTY OF KENT
RECEIVED FOR RECORD
97 APR 29 AM 8:26
REG. OF DEEDS

LAND CORNER RECORDATION CERTIFICATE
Filing Requirement of Act 74, Mich. P.A. 1970

For corners in KENT COUNTY (County)

	Located In:	Corner Code #
1. Public Land Survey	T 6N R 9W	K-11
	T___ R___	
	T___ R___	
	T___ R___	
2. Property Controlling	S___ T___ R___	
in Section	S___ T___ R___	
3. Miscellaneous	S___ T___ R___	
Property in Sec.	S___ T___ R___	

9880

Register of Deeds Stamp & File Number

4. Lot No. _____ , Recorded Plat _____

5. Private Claims _____

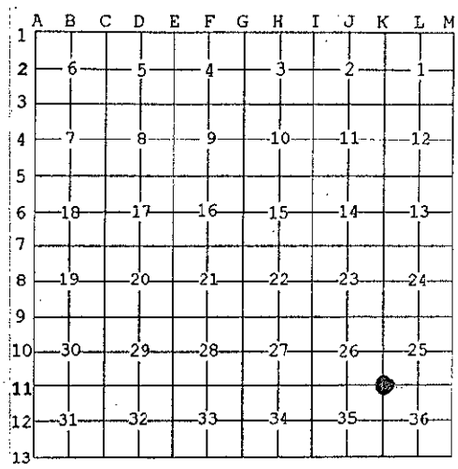

I, Kirk Breitels, in a field survey on Jan. 16, 19 97 do hereby state that under requirements of P.A. 74, Michigan P.A. of 1970, the corner points mentioned in lines 1 and 2 above were in conformance with regulations and rules therefore as required in the current manual of survey instructions of the United States Department of the Interior, Bureau of Land Management or by a decree of a Court of Law and /or that the corner points mentioned in lines 3, 4 and 5 above were in conformance with the rules of the Michigan Board of Land Surveyors or by a Decree of a Court of Law; established, re-established, monumented, recovered, found as expressed below:

NOTE: Not more than 2 corners, all in the same town and range, may be recorded on this certificate.

A. Description of original monument and accessories and/or subsequent restoration:

K-11	1830	GLO	Mullett	Set Post
	1966	Kent Co. Wit.		Mon. Box
	1981	LCRC #2081	Nederveld	1" Iron in Mon. Box
	1982	LCRC #3082	Merdzinski	Set Kent County Monument
	1990	LCRC #5446	Starr	Kent County Monument

The position of this corner was previously approved by the Kent County Remonumentation Peer Group, monumented by John A. Merdzinski on 7-29-82 and was recorded per LCRC #3082

B. Description of corner evidence found and/or method applied in restoring or reestablishing corner:

K-11 Found standard Kent Co. Mon. (Harrison) per witnesses from above LCRC as set by John A. Merdzinski in place of the 1" Iron over a 3/4" Iron he found inside a Mon. Box. Both Irons checks with Kent Co. Wit. and LCRC #3082.

LCRC #3082			LCRC #5446		
Nail & tag 18" Walnut	N30°W	37.02'	Same witnesses as LCRC #3082 plus		
Nail & tag 20" Walnut	N50°W	44.65'	Nail & tag 6" Elm	S70°W	86.75'
Nail & tag 30" Maple	N25°E	28.55'			
Nail & tag 26" Maple	S70°E	107.30'			
C/L W. end conc. culv.	S20°W	62.2'			

The selected location is accepted by me and is generally accepted by professional surveyors as the best available evidence of the position of the original corner.

C. Description of monument for corner and accessories established to perpetuate locating the position of the corner:

K-11 Standard Kent County Monument

Nail & KC Remon. tag E. side 20" Walnut	N30°W	37.00'
Nail & KC Remon. tag SW side 24" Walnut	N50°W	44.65'
Nail & KC Remon. tag W. side 34" Maple	N25°E	28.57'
Nail & KC Remon. tag N. side 30" Maple	S70°E	107.26'
Nail & KC Remon. tag N. side Clust. 6" Elms	S75°W	104.49'
Centerline West end concrete culvert	S20°W	62.20'
On C/L bit. roads East-West-South		

STATE OF MICHIGAN
KIRK BREITELS
LAND SURVEYOR
NO 30077
LICENSED LAND SURVEYOR

Signed by Kirk Breitels Date 3/27/97

Surveyor's Michigan License No. 30077

P.A. 345 1990 KENT COUNTY
PEER APPROVED 3/27/97
CHAIRMAN Harry Kuiper

FORM APPROVED BY MICHIGAN STATE BOARD OF PROFESSIONAL SURVEYORS, JAN. 28, 1971
REVISED MAY 14,1975
REVISED JAN., 1983
REVISED OCT., 1995