

SURVEY & REMONUMENTATION

MAR 03 1998

KENT COUNTY REMONUMENTATION

SECTION

LAND CORNER RECORDATION CERTIFICATE
Filing Requirement of Act 74, Mich. P.A. 1970

For corners in

KENT COUNTY

(County)

Located In:

Corner Code #

1. Public Land Survey	T	6N	R	9W	K-13
	T		R		
	T		R		
	T		R		
2. Property Controlling in Section	S		T	R	
	S		T	R	
3. Miscellaneous Property in Sec.	S		T	R	
	S		T	R	

REG. OF DEEDS
97 APR 29 AM 8:27
STATE OF MICHIGAN
COUNTY OF KENT
RECEIVED FOR RECORD

9881

Register of Deeds Stamp & File Number

4. Lot No. _____, Recorded Plat _____
5. Private Claims _____

I, Kirk Breitels, in a field survey on Jan. 16, 1997 do hereby state that under requirements of P.A. 74, Michigan P.A. of 1970, the corner points mentioned in lines 1 and 2 above were in conformance with regulations and rules therefore as required in the current manual of survey instructions of the United States Department of the Interior, Bureau of Land Management or by a decree of a Court of Law and /or that the corner points mentioned in lines 3, 4 and 5 above were in conformance with the rules of the Michigan Board of Land Surveyors or by a Decree of a Court of Law; established, re-established, monumented, recovered, found as expressed below.

NOTE: Not more than 2 corners, all in the same town and range, may be recorded on this certificate.

1	A	B	C	D	E	F	G	H	I	J	K	L	M
2	6		5		4		3		2		1		
3													
4	7		8		9		10		11		12		
5													
6	18		17		16		15		14		13		
7													
8	19		20		21		22		23		24		
9													
10	30		29		28		27		26		25		
11													
12	31		32		33		34		35		36		
13													

A. Description of original monument and accessories and/or subsequent restoration:

K-13	1830	GLO	Mullett	Set Post
	1984	LCRC #4050	Meyer	PK Nail
	1985	LCRC #4108	Jonker	Set Kent County Monument
	1990	LCRC #5448	Starr	Kent County Monument

The position of this corner was previously approved by the Kent County Remonumentation Peer Group, monumented by Robert J. Jonker on 1-25-85 and was recorded per LCRC #4108

B. Description of corner evidence found and/or method applied in restoring or reestablishing corner:


K-13 Found standard Kent Co. Mon. (Harrison) per witnesses from above LCRC as set by Robert J. Jonker in place of the PK Nail he found. Said PK Nail checks with LCRC #4050 and GLO jog.

<u>LCRC #4108</u>	KC Mon. in Mon. Box West	8.58'	<u>LCRC #5448</u>	KC Mon. in Mon. Box West	8.58'
	Nail & tag P. Pole	N70°W 64.20'		Nail & tag P. Pole	N70°W 64.20'
	Spike in P. Pole	S60°W 68.35'		Nail & tag P. Pole	S60°W 68.40'
	Spike in 20" Maple	S35°W 83.18'		Nail & tag 20" Maple	S35°W 83.18'
	C/L stop sign post	N50°E 45.1'		Nail & tag wood post	S60°E 45.32'

The selected location is accepted by me and is generally accepted by professional surveyors as the best available evidence of the position of the original corner.

C. Description of monument for corner and accessories established to perpetuate locating the position of the corner:

K-13 Standard Kent County Monument					
Nail & KC Remon. tag S. side P. Pole	N70°W	64.20'			
Nail & KC Remon. tag NW side P. Pole	S60°W	68.37'			
Nail & KC Remon. tag SE side 26" Maple	S35°W	83.10'			
Centerline stop sign leg	N50°E	45.10'			
Nail & KC Remon. tag N. side wood post	S60°E	45.38'			
Kent Co. Mon. in mon. box (K-1, 5-9)	West	8.58'			

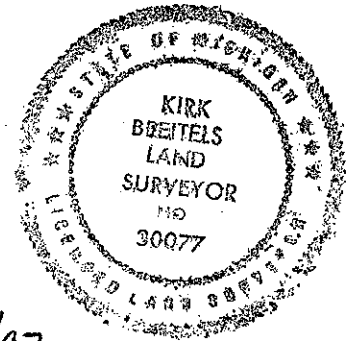

Signed by Kirk Breitels
Surveyor's Michigan License No. 30077

Date 3/27/97

P.A. 345 1990 KENT COUNTY
PEER APPROVED 3/27/97
CHAIRMAN Harry Thubert