SURVEY & REMONUMENTATION

MAR 0 3 1998

KENT COUNTY REMONUMENTATION

STATE OF MICHIGAN
COUNTY OF KENT
RECEIVED FOR RECORD

97 APR 29 AM 8:27

REG. OF DEEDS

SECTION

LAND CORNER RECORDATION CERTIFICATE
Filing Requirement of Act 74, Mich. P.A. 1970

For corners in KENT COUNTY (County)

	Located In:	Corner Code #
1. Public Land Survey	T 6N R 9W	L-3
	T___ R___	
	T___ R___	
	T___ R___	
2. Property Controlling	S___ T___ R___	
in Section	S___ T___ R___	
3. Miscellaneous	S___ T___ R___	
Property in Sec.	S___ T___ R___	

9883

Register of Deeds Stamp & File Number

4. Lot No. _____, Recorded Plat _____
5. Private Claims _____

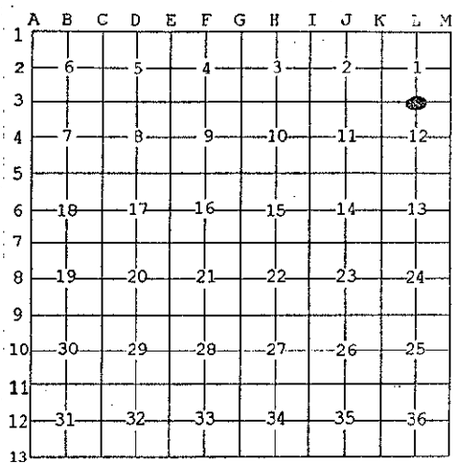

I, Kirk Breitels, in a field survey on Jan. 6, 19 97 do hereby state that under requirements of P.A. 74, Michigan P.A. of 1970, the corner points mentioned in lines 1 and 2 above were in conformance with regulations and rules therefore as required in the current manual of survey instructions of the United States Department of the Interior, Bureau of Land Management or by a decree of a Court of Law and /or that the corner points mentioned in lines 3, 4 and 5 above were in conformance with the rules of the Michigan Board of Land Surveyors or by a Decree of a Court of Law; established, re-established, monumented, recovered, found as expressed below:

NOTE: **Not more than 2 corners, all in the same town and range, may be recorded on this certificate.**

A. Description of original monument and accessories and/or subsequent restoration:

L-3	1830	GLO	Mullett	Set Post
		Kent Co. Wit.		No. desc. - witnesses given
	1951-69	Williams & Works		Iron - Boat spike over iron
	1985	LCRC #4162	Rosema	Set Kent County Monument
	1990	LCRC #5449	Starr	Kent County Monument

The position of this corner was previously approved by the Kent County Remonumentation Peer Group, monumented by Maurice J. Rosema on 4-1-85 and was recorded per LCRC #4162

B. Description of corner evidence found and/or method applied in restoring or reestablishing corner:

L-3 Found standard Kent Co. Mon. (Harrison) per witnesses from above LCRC as set by Maurice J. Rosema in place of the Boat Spike he found. Said Boat Spike checks with Williams & Works information

LCRC #4162			LCRC #5449
Nail & tag 36" Oak	S60°E	99.27'	same witnesses as LCRC #4162
Nail & tag 6" Oak	S26°E	38.35'	
Nail & tag Clump 8" Oak	S69°W	69.66'	
Nail & tag 10" Elm	N52°W	43.91'	
Nail & tag 8" Oak	N71°E	74.37'	

The selected location is accepted by me and is generally accepted by professional surveyors as the best available evidence of the position of the original corner.

C. Description of monument for corner and accessories established to perpetuate locating the position of the corner:

L-3 Standard Kent County Monument

New Nail & KC Remon. tag SW side 40" Oak	S60°E	99.32'
Nail & KC Remon. tag W. side 8" Oak	S26°E	38.41'
Nail & KC Remon. tag NW side Clump 8" Oak	S69°W	69.66'
New Nail & KC Remon. tag NE side 12" Elm	N52°W	43.91'
Nail & KC Remon. tag NW side 12" Oak	N71°E	74.39'

On C/L E-W asphalt road

STATE OF MICHIGAN
KIRK BREITELS
LAND SURVEYOR
NO 30077
LICENSED LAND SURVEYOR

Signed by Kirk Breitels Date 3/27/97

Surveyor's Michigan License No. 30077

P.A. 345 1990 KENT COUNTY
PEER APPROVED 3/27/97
CHAIRMAN Larry Huber

FORM APPROVED BY MICHIGAN STATE BOARD OF PROFESSIONAL SURVEYORS, JAN. 28, 1971
REVISED MAY 14, 1975
REVISED JAN., 1983
REVISED OCT., 1995