

**SURVEY & REMONUMENTATION**

MAR 03 1998

**KENT COUNTY REMONUMENTATION**

SECTION

**LAND CORNER RECORDATION CERTIFICATE**  
Filing Requirement of Act 74, Mich. P.A. 1970

STATE OF MICHIGAN  
COUNTY OF KENT  
RECEIVED FOR RECORD  
97 OCT 14 AM 10:01  
REG. OF DEEDS  
*Lucy Stand*

| For corners in<br>KENT COUNTY<br>(County) | Located In:             | Corner Code # |
|---|-------------------------|---------------|
| 1. Public Land Survey                     | T <u>6N</u> R <u>9W</u> | L-4           |
|   | T _____ R _____         | _____         |
|   | T _____ R _____         | _____         |
|   | T _____ R _____         | _____         |
| 2. Property Controlling<br>in Section     | S _____ T _____ R _____ | _____         |
|   | S _____ T _____ R _____ | _____         |
| 3. Miscellaneous<br>Property in Sec.      | S _____ T _____ R _____ | _____         |

10045

Register of Deeds Stamp & File Number

4. Lot No. \_\_\_\_\_, Recorded Plat \_\_\_\_\_  
5. Private Claims \_\_\_\_\_

|    | A  | B  | C  | D  | E  | F  | G | H | I | J | K | L | M |
|----|----|----|----|----|----|----|---|---|---|---|---|---|---|
| 1  |    |    |    |    |    |    |   |   |   |   |   |   |   |
| 2  | 6  | 5  | 4  | 3  | 2  | 1  |   |   |   |   |   |   |   |
| 3  |    |    |    |    |    |    |   |   |   |   |   |   |   |
| 4  | 7  | 8  | 9  | 10 | 11 | 12 |   |   |   |   |   |   |   |
| 5  |    |    |    |    |    |    |   |   |   |   |   |   |   |
| 6  | 18 | 17 | 16 | 15 | 14 | 13 |   |   |   |   |   |   |   |
| 7  |    |    |    |    |    |    |   |   |   |   |   |   |   |
| 8  | 19 | 20 | 21 | 22 | 23 | 24 |   |   |   |   |   |   |   |
| 9  |    |    |    |    |    |    |   |   |   |   |   |   |   |
| 10 | 30 | 29 | 28 | 27 | 26 | 25 |   |   |   |   |   |   |   |
| 11 |    |    |    |    |    |    |   |   |   |   |   |   |   |
| 12 | 31 | 32 | 33 | 34 | 35 | 36 |   |   |   |   |   |   |   |
| 13 |    |    |    |    |    |    |   |   |   |   |   |   |   |

I, Kirk Breitels, in a field survey on June 17, 1997 do hereby state that under requirements of P.A. 74, Michigan P.A. of 1970, the corner points mentioned in lines 1 and 2 above were in conformance with regulations and rules therefore as required in the current manual of survey instructions of the United States Department of the Interior, Bureau of Land Management or by a decree of a Court of Law and for that the corner points mentioned in lines 3, 4 and 5 above were in conformance with the rules of the Michigan Board of Land Surveyors or by a Decree of a Court of Law, established, re-established, monumented, recovered, found as expressed below:

NOTE: Not more than 2 corners, all in the same town and range, may be recorded on this certificate.

A. Description of original monument and accessories and/or subsequent restoration:

- L-4 1830---GLO---Not Set  
 1905-47---Williams & Works---Fence Corner for Center  
 1951-69---Williams & Works---Set/Used Iron at Fence Corner for Center  
 Kent Co. Wits.---No information  
 1996---Survey---Vugtveen---Found 1" Round Iron  
 Nail in 30" Oak N85°E 5.27' Nail in 36" Oak S70°W 10.62'  
 Nail in 16" Hickory S15°W 29.47' Nail in Tw. 10" Oak N10°W 76.33'

B. Description of corner evidence found and/or method applied in restoring or reestablishing corner:


- L-4 Found 1" Round Iron at fence corner for fences to South and East. Fits witnesses per Vugtveen survey.  
 Fd. spike in 30" Oak N85°E 5.29' Fd. spike in 36" Oak S70°W 10.62'  
 Fd. spike in 16" Hickory S15°W 29.47' Fd. spike in Tw. 10" Oak N10°W 76.38'

The 1" Round Iron is 0.1' S. and 0.3' E. from intersection of 1/4 lines and agrees with measurments of others.

The 1" Round Iron is accepted by me and is generally accepted by professional surveyors as the best available evidence of the position of the corner.

C. Description of monument for corner and accessories established to perpetuate locating the position of the corner:

- L-4 Set Standard Kent Co. Monument (Harrison) in place of the 1" Round Iron  
 Spike in N. side 30" Oak N85°E 5.29'  
 Spike in SE side 36" Oak S70°W 10.62'  
 Spike in W. side 16" Hickory S15°W 29.47'  
 Spike in SW side Tw. 10" Oak N10°W 76.38'  
 Fence Corner South and East is SE 1'±

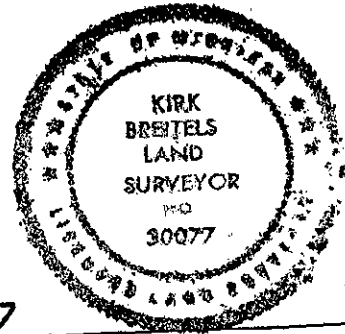

Signed by *Kirk Breitels*  
 Surveyor's Michigan License No. 30077

Date 8/28/97

P.A. 345 1990 KENT COUNTY  
 PEER APPROVED 7/24/97  
 CHAIRMAN *Harry Hubert*