

SURVEY & REMONUMENTATION

MAR 03 1998

KENT COUNTY REMONUMENTATION

STATE OF MICHIGAN
COUNTY OF KENT
RECEIVED FOR RECORD

97 APR 29 AM 8:27

LAND CORNER RECORDATION CERTIFICATE
Filing Requirement of Act 74, Mich. P.A. 1970

For corners in
KENT COUNTY
(County)

SECTION

Located In:

Corner Code #

1. Public Land Survey	T 6N R 9W	L-5
	T R	
	T R	
	T R	
2. Property Controlling in Section	S T R	
	S T R	
3. Miscellaneous Property in Sec.	S T R	
	S T R	

REG. OF DEEDS

9884

Register of Deeds Stamp & File Number

4. Lot No. _____, Recorded Plat _____
5. Private Claims _____

I, Kirk Breitels, in a field survey on Jan. 10, 1997 do hereby state that under requirements of P.A. 74, Michigan P.A. of 1970, the corner points mentioned in lines 1 and 2 above were in conformance with regulations and rules therefore as required in the current manual of survey instructions of the United States Department of the Interior, Bureau of Land Management or by a decree of a Court of Law and/or that the corner points mentioned in lines 3, 4 and 5 above were in conformance with the rules of the Michigan Board of Land Surveyors or by a Decree of a Court of Law; established, re-established, monumented, recovered, found as expressed below:

	A	B	C	D	E	F	G	H	I	J	K	L	M
1													
2	6		5		4		3		2		1		
3													
4	7		8		9		10		11		12		
5													
6	10		17		16		15		14		13		
7													
8	19		20		21		22		23		24		
9													
10	30		29		28		27		26		25		
11													
12	31		32		33		34		35		36		
13													

NOTE: Not more than 2 corners, all in the same town and range, may be recorded on this certificate.

A. Description of original monument and accessories and/or subsequent restoration:

L-5	1830	GLO	Mullett	Set Post
		Kent Co. Wit.		Concrete Monument
	1973	LCRC #476	Spicer	Monument
	1981	LCRC #2233	Jonker	Set Kent County Monument
	1990	LCRC #5450	Starr	Kent County Monument

The position of this corner was previously approved by the Kent County Remonumentation Peer Group, monumented by Robert J. Jonker on 10-28-81 and was recorded per LCRC #2233

B. Description of corner evidence found and/or method applied in restoring or reestablishing corner:


L-5 Found standard Kent Co. Mon. (Harrison) per witnesses from above LCRC as set by Robert J. Jonker in place of the Concrete Monument he found. Said Concrete Monument checks with Kent Co. Wit. and LCRC #476

LCRC #2233	Remon. tag 50" Maple	S38°W 32.52'	
	Remon. tag Tri. 12" Oak	S39°E 36.81'	LCRC #5450
	Remon. tag 12" Oak	N28°E 31.69'	same witness as LCRC #2233
	Remon. tag 12" Oak	N41°W 39.50'	1" Round Iron
	Remon. tag 34" Oak	S72°W 74.58'	N04°E 32.8'

The selected location is accepted by me and is generally accepted by professional surveyors as the best available evidence of the position of the original corner.

C. Description of monument for corner and accessories established to perpetuate locating the position of the corner:

L-5	Standard Kent County Monument		
	Nail & KC Remon. tag NW side 50" stump	S38°W 32.52'	
	Nail & KC Remon. tag W side Tri. 16"-24" Oak	S39°E 36.79'	
	Nail & KC Remon. tag W side 16" Oak	N28°E 31.64'	
	Nail & KC Remon. tag SW side 16" Oak	N41°W 39.46'	
	Nail & KC Remon. tag NW side 36" Oak	S72°W 74.55'	
	1" Round Iron	N04°E 32.80'	
	On C/L of East & West bit. road (28th St.)		

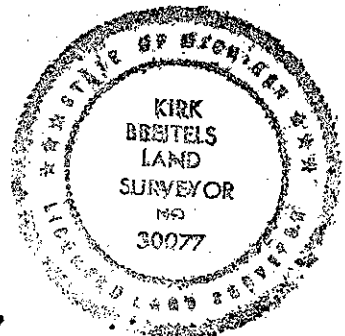

Signed by Kirk Breitels

Date 3/27/97

Surveyor's Michigan License No. 30077

P.A. 345 1990 KENT COUNTY

PEER APPROVED 3/27/97
CHAIRMAN [Signature]