

SURVEY & REMONUMENTATION

MAR 03 1998

KENT COUNTY REMONUMENTATION

SECTION

**LAND CORNER RECORDATION CERTIFICATE
Filing Requirement of Act 74, Mich. P.A. 1970**

For corners in
KENT COUNTY
(County)

Located In:	Corner Code #
T 6N R 9W	L-7
T R	
T R	
T R	
T R	
S T R	
S T R	
S T R	
S T R	

1. Public Land Survey

2. Property Controlling in Section

3. Miscellaneous Property in Sec.

4. Lot No. _____, Recorded Plat _____

5. Private Claims _____

REG. OF DEEDS

David Bond

97 APR 29 AM 8:27

STATE OF MICHIGAN
COUNTY OF KENT
RECEIVED FOR RECORD

9885

Register of Deeds Stamp & File Number

I, Kirk Breitels, in a field survey on Jan. 3, 1997 do hereby state that under requirements of P.A. 74, Michigan P.A. of 1970, the corner points mentioned in lines 1 and 2 above were in conformance with regulations and rules therefore as required in the current manual of survey instructions of the United States Department of the Interior, Bureau of Land Management or by a decree of a Court of Law and /or that the corner points mentioned in lines 3, 4 and 5 above were in conformance with the rules of the Michigan Board of Land Surveyors or by a Decree of a Court of Law; established, re-established, monumented, recovered, found as expressed below:

NOTE: Not more than 2 corners, all in the same town and range, may be recorded on this certificate.

	A	B	C	D	E	F	G	H	I	J	K	L	M
1													
2	6		5		4		3		2		1		
3													
4	7		8		9		10		11		12		
5													
6	10		17		16		15		14		13		
7													
8	19		20		21		22		23		24		
9													
10	30		29		28		27		26		25		
11													
12	31		32		33		34		35		36		
13													

A. Description of original monument and accessories and/or subsequent restoration:

L-7	1830	GLO	Mullett	Set Post
	1939	Kent Co. Wit.		Monument
	1970	Williams & Works		Concrete Monument
	1984	LCRC #4104	Rosema	Set Kent County Monument
	1990	LCRC #5451	Starr	Kent County Monument

The position of this corner was previously approved by the Kent County Remonumentation Peer Group, monumented by Maurice J. Rosema on 12/21/84 and was recorded per LCRC #4104

B. Description of corner evidence found and/or method applied in restoring or reestablishing corner:


L-7 Found standard Kent Co. Mon. (Harrison) per witnesses from above LCRC as set by Maurice J. Rosema in place of the Concrete Monument he found. Said Concrete Monument checks with Kent Co. Wit. and Williams & Works information.

LCRC #4104		LCRC #5451	
Nail & tag P. Pole	S73°E 163.21'	Nail & tag P. Pole	S73°E 163.21'
Nail & tag 6" Ash	N67°E 52.75'	Nail & tag 6" Ash	N67°E 52.75'
Nail & tag 15" Oak	N08°E 47.75'	Nail & tag 15" Oak	N08°E 47.75'
Nail & tag 10" Oak	N55°W 45.01'	Nail & tag 18" Cherry	N65°W 43.68'
Nail & tag 15" Cherry	N65°W 59.68'	Nail & tag P. Pole	N20°W 34.48'

The selected location is accepted by me and is generally accepted by professional surveyors as the best available evidence of the position of the original corner.

C. Description of monument for corner and accessories established to perpetuate locating the position of the corner:

L-7	Standard Kent County Monument		
Nail & KC Remon. tag S. side P. Pole	S73°E	163.28'	
Nail & KC Remon. tag SE side 8" Ash	N67°E	52.80'	
Nail & KC Remon. tag E. side 20" Oak	N08°E	47.72'	
Nail & KC Remon. tag S. side 24" Cherry	N65°W	43.68'	
Nail & KC Remon. tag E. side P. Pole	N20°W	34.53'	
On C/L gravel road East and West			
On tree row North			

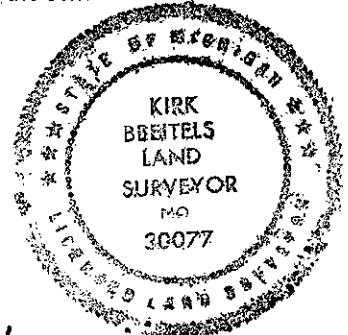

Signed by *Kirk Breitels*
Surveyor's Michigan License No. 30077

Date 3/27/97

P.A. 345 1990 KENT COUNTY

PEER APPROVED 3/27/97

CHAIRMAN *Harry Huber*

FORM APPROVED BY MICHIGAN STATE BOARD OF PROFESSIONAL SURVEYORS, JAN. 28, 1971
REVISED MAY 14, 1975
REVISED JAN., 1983
REVISED OCT., 1985