

**SURVEY & REMONUMENTATION**

MAR 03 1998

**KENT COUNTY REMONUMENTATION**

**SECTION**

**LAND CORNER RECORDATION CERTIFICATE**  
Filing Requirement of Act 74, Mich. P.A. 1970

For corners in  
KENT COUNTY

Located In:

Corner Code #

(County)

- |                                    |  |            |
|------------------------------------|--|------------|
| 1. Public Land Survey              | T <u>6N</u> R <u>9W</u>                | <u>L-8</u> |
|                                    | T <u>   </u> R <u>   </u>              | <u>   </u> |
|                                    | T <u>   </u> R <u>   </u>              | <u>   </u> |
|                                    | T <u>   </u> R <u>   </u>              | <u>   </u> |
| 2. Property Controlling in Section | S <u>   </u> T <u>   </u> R <u>   </u> | <u>   </u> |
|                                    | S <u>   </u> T <u>   </u> R <u>   </u> | <u>   </u> |
| 3. Miscellaneous Property in Sec.  | S <u>   </u> T <u>   </u> R <u>   </u> | <u>   </u> |
|                                    | S <u>   </u> T <u>   </u> R <u>   </u> | <u>   </u> |

STATE OF MICHIGAN  
COUNTY OF KENT  
RECEIVED FOR RECORD  
97 OCT 14 AM 10:32  
10073  
REG. OF DEEDS  
*Luis Standa*

Register of Deeds Stamp & File Number

4. Lot No. \_\_\_\_\_, Recorded Plat \_\_\_\_\_  
5. Private Claims \_\_\_\_\_

I, Kirk Breitels, in a field survey on July 31, 1997 do hereby state that under requirements of P.A. 74, Michigan P.A. of 1970, the corner points mentioned in lines 1 and 2 above were in conformance with regulations and rules therefore as required in the current manual of survey instructions of the United States Department of the Interior, Bureau of Land Management or by a decree of a Court of Law and/or that the corner points mentioned in lines 3, 4 and 5 above were in conformance with the rules of the Michigan Board of Land Surveyors or by a Decree of a Court of Law; established, re-established, monumented, recovered, found as expressed below:

NOTE: Not more than 2 corners, all in the same town and range, may be recorded on this certificate.

A	B	C	D	E	F	G	H	I	J	K	L	M
1												
2	6		5		4		3		2		1	
3												
4	7		8		9		10		11		12	
5												
6	18		17		16		15		14		13	
7												
8	19		20		21		22		23		24	
9												
10	30		29		28		27		26		25	
11												
12	31		32		33		34		35		36	
13												

A. Description of original monument and accessories and/or subsequent restoration:

- L-8 1830---GLO---Not Set  
Williams & Works---No information  
Kent Co. Wits.---No information

P.A. 345 1990 KENT COUNTY  
PEER APPROVED 9/28/97  
CHAIRMAN Harry Huber


B. Description of corner evidence found and/or method applied in restoring or reestablishing corner:

- L-8 Established Intersection of 1/4 lines and found an E-W fence to be 1' North ±.  
No fences or occupation to North or South.

The Intersection of 1/4 lines is accepted by me and is generally accepted by professional surveyors as the best available evidence of the position of the corner.

C. Description of monument for corner and accessories established to perpetuate locating the position of the corner:

- L-8 Set Standard Kent Co. Monument (Harrison) at the Intersection of 1/4 lines.  
Nail & KC Remon. tag E. side 20" Beech S05°E 17.47'  
Nail & KC Remon. tag NW side 24" Beech S50°W 42.50'  
Nail & KC Remon. tag S. side 12" Beech N80°W 38.57'  
Nail & KC Remon. tag NE side 14" Maple N35°W 62.80'  
Nail & KC Remon. tag NW side 16" Ash N30°E 34.00'  
Mon. is NW'ly of the 14th tee of "Deer Run Golf Course"

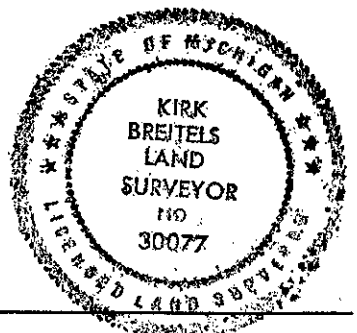

Signed by *Kirk Breitels*  
Surveyor's Michigan License No. 30077

Date 9/15/97