SURVEY & REMONUMENTATION

MAR 03 1998

2/2

KENT COUNTY REMONUMENTATION

SECTION

LAND CORNER RECORDATION CERTIFICATE
Filing Requirement of Act 74, Mich. P.A. 1970

STATE OF MICHIGAN COUNTY OF KENT RECEIVED FOR RECORD 97 APR 29 AM 8:27 REG. OF DEEDS

9887

Register of Deeds Stamp & File Number

For corners in KENT COUNTY (County)

	Located In:	Corner Code #
1. Public Land Survey	T 6N R 9W	L-11
	T___ R___	
	T___ R___	
	T___ R___	
2. Property Controlling in Section	S___ T___ R___	
	S___ T___ R___	
3. Miscellaneous Property in Sec.	S___ T___ R___	
	S___ T___ R___	

4. Lot No. _____, Recorded Plat _____
5. Private Claims _____

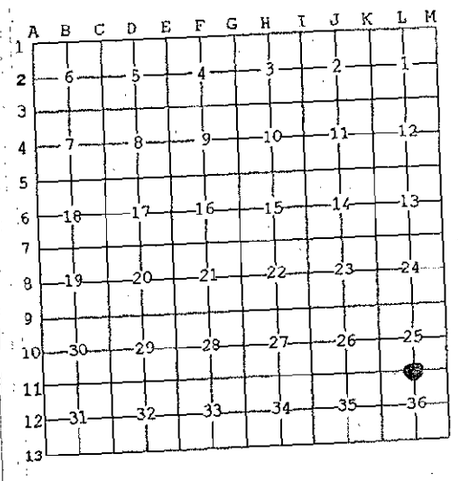

I, Kirk Breitels, in a field survey on Jan. 10, 19 97 do hereby state that under requirements of P.A. 74, Michigan P.A. of 1970, the corner points mentioned in lines 1 and 2 above were in conformance with regulations and rules therefore as required in the current manual of survey instructions of the United States Department of the Interior, Bureau of Land Management or by a decree of a Court of Law and /or that the corner points mentioned in lines 3, 4 and 5 above were in conformance with the rules of the Michigan Board of Land Surveyors or by a Decree of a Court of Law; established, re-established, monumented, recovered, found as expressed below:

NOTE: Not more than 2 corners, all in the same town and range, may be recorded on this certificate.

A. Description of original monument and accessories and/or subsequent restoration:

L-11	1830	GLO	Mullett	Set Post
	1959	Kent Co. Wit.		1/2" Iron in Mon. box
	1974	LCRC #633	Spicer	3/4" Iron in Mon. box
	1981	LCRC #2574	Bueche	Set Kent County Monument
	1990	LCRC #5453	Starr	Kent County Monument

The position of this corner was previously approved by the Kent County Remonumentation Peer Group, monumented by John C. Bueche on 12-13-81 and was recorded per LCRC #2574

B. Description of corner evidence found and/or method applied in restoring or reestablishing corner:
L-11 Found standard Kent Co. Mon. (Harrison) per witnesses from above LCRC as set by John C. Bueche in place of the 3/4" Iron he found inside a Mon. box. Said Iron in Mon. box checks with Kent Co. Wit. and LCRC #633.

LCRC #2574
"X" on culv. N50°W 38.81' "X" on culv. S55°W 37.42'
Nail & tag wood fc. post N65°E 63.64'
Nail & tag 8" Elm N55°W 52.05'
PK Nail top of fc. post N30°W 42.18'
PK Nail top of fc. post N15°E 35.15'

LCRC #5453
"X" on culv. N50°W 38.81'
"X" on culv. S55°W 37.42'
Nail/tag fc. post N65°E 63.64'
Nail/tag 8" Elm N65°W 67.10'
Nail/tag 6" Elms N70°E 59.38'

The selected location is accepted by me and is generally accepted by professional surveyors as the best available evidence of the position of the original corner.

C. Description of monument for corner and accessories established to perpetuate locating the position of the corner:

L-11 Standard Kent County Monument
"X" cut North end conc. culvert N50°W 38.81'
"X" cut South end conc. culvert S55°W 37.42'
Nail & KC Remon. tag NW side wood fc. post N65°E 63.77'
Nail & KC Remon. tag S. side clump stumps N70°E 59.38'
Nail & KC Remon. tag S. side Tw. 6" Hickory N70°W 80.03'
C/L of East & West bit. road is 1' North

STATE OF MICHIGAN KIRK BREITELS LAND SURVEYOR NO 30077 LICENSED LAND SURVEYOR

Signed by Kirk Breitels Date 3/27/97

Surveyor's Michigan License No. 30077

P.A. 345 1990 KENT COUNTY
PEER APPROVED 3/27/97
CHAIRMAN Harry Huber

FORM APPROVED BY MICHIGAN STATE BOARD OF PROFESSIONAL SURVEYORS, JAN. 28, 1971
REVISED MAY 14, 1975
REVISED JAN., 1983
REVISED OCT., 1995