

SURVEY & REMONUMENTATION

MAR 03 1998

KENT COUNTY REMONUMENTATION

LAND CORNER RECORDATION CERTIFICATE
Filing Requirement of Act 74, Mich. P.A. 1970

For corners in **SECTION**

KENT COUNTY

(County)

Located In:

Corner Code #

1. Public Land Survey

T 6N R 9W L-13
T _____ R _____
T _____ R _____
T _____ R _____

2. Property Controlling in Section

S _____ T _____ R _____
S _____ T _____ R _____

3. Miscellaneous Property in Sec.

S _____ T _____ R _____
S _____ T _____ R _____

4. Lot No. _____, Recorded Plat _____

5. Private Claims _____

REG. OF DEEDS

Lucy Bond

97 APR 29 AM 8:27

STATE OF MICHIGAN
COUNTY OF KENT
RECEIVED FOR RECORD

9888

Register of Deeds Stamp & File Number

I, Kirk Breitels, in a field survey on Jan. 6, 19 97 do hereby state that under requirements of P.A. 74, Michigan P.A. of 1970, the corner points mentioned in lines 1 and 2 above were in conformance with regulations and rules therefore as required in the current manual of survey instructions of the United States Department of the Interior, Bureau of Land Management or by a decree of a Court of Law and /or that the corner points mentioned in lines 3, 4 and 5 above were in conformance with the rules of the Michigan Board of Land Surveyors or by a Decree of a Court of Law; established, re-established, monumented, recovered, found as expressed below:

NOTE: Not more than 2 corners, all in the same town and range, may be recorded on this certificate.

	A	B	C	D	E	F	G	H	I	J	K	L	M
1													
2	6		5		4		3		2		1		
3													
4	7		8		9		10		11		12		
5													
6	18		17		16		15		14		13		
7													
8	19		20		21		22		23		24		
9													
10	30		29		28		27		26		25		
11													
12	31		32		33		34		35		36		
13													

A. Description of original monument and accessories and/or subsequent restoration:

L-13	1830	GLO	Mullett	Set Post
	1936	Kent Co. Wit.		Concrete Monument
	1981	LCRC #1625	Byl	Concrete Monument
	1985	LCRC #4109	Jonker	Set Kent County Monument
	1990	LCRC #5454	Starr	Kent County Monument

The position of this corner was previously approved by the Kent County Remonumentation Peer Group, monumented by Robert J. Jonker on 1/21/85 and was recorded per LCRC #4109

B. Description of corner evidence found and/or method applied in restoring or reestablishing corner:

L-13 Found standard Kent Co. Mon. (Harrison) per witnesses from above LCRC as set by Robert J. Jonker in place of the Concrete Monument he found. Said Concrete Monument checks with Kent Co. Wit. and LCRC #1625.

LCRC #4109

Remon. tag 16" Maple	S65°E	58.90'	
Remon. tag 12" Maple	S05°W	17.12'	KC Mon.
Remon. tag 10" Cherry	N10°E	50.35'	(L-1, 5-9)
Remon. tag P. Pole	N80°E	115.53'	West 6.0'
Remon. tag 10" Oak	N40°E	62.90'	

LCRC #5454

same witnesses as LCRC #4109


The selected location is accepted by me and is generally accepted by professional surveyors as the best available evidence of the position of the original corner.

C. Description of monument for corner and accessories established to perpetuate locating the position of the corner:

L-13 Standard Kent County Monument

Nail & KC Remon. tag N. side 20" Maple	S65°E	58.91'
Nail & KC Remon. tag E. side 18" Maple	S05°W	17.20'
Nail & KC Remon. tag E. side 14" Cherry	N10°E	50.36'
Nail & KC Remon. tag S. side new P. Pole	N80°E	110.60'
Nail & KC Remon. tag NW side 18" Oak	N40°E	62.96'
Kent Co. Mon. (L-1, T5N, R9W)	West	6.00'

C/L of East & West gravel road is 2' North
On tree row North and South

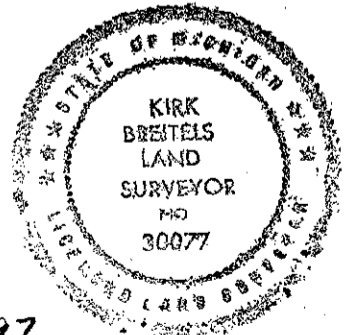

Signed by

Kirk Breitels

Date

3/27/97

Surveyor's Michigan License No. 30077

P.A. 345 1990 KENT COUNTY

PEER APPROVED *3/27/97*

CHAIRMAN *Harry Kube*