

SURVEY & REMONUMENTATION

MAR 03 1998

KENT COUNTY REMONUMENTATION

SECTION

LAND CORNER RECORDATION CERTIFICATE
Filing Requirement of Act 74, Mich. P.A. 1970

For corners in
KENT COUNTY
(County)

Located In:	Corner Code #
1. Public Land Survey T 6N R 9W	M-1
T R	
T R	
T R	
2. Property Controlling in Section S T R	
S T R	
3. Miscellaneous Property in Sec. S T R	
S T R	

REG. OF DEEDS
STATE OF MICHIGAN
COUNTY OF KENT
RECEIVED FOR RECORD
97 APR 29 AM 8:27
Lucy Spauld

9889

Register of Deeds Stamp & File Number

4. Lot No. _____, Recorded Plat _____
5. Private Claims _____

I, Kirk Breitels, in a field survey on Feb. 20 1997 do hereby state that under requirements of P.A. 74, Michigan P.A. of 1970, the corner points mentioned in lines 1 and 2 above were in conformance with regulations and rules therefore as required in the current manual of survey instructions of the United States Department of the Interior, Bureau of Land Management or by a decree of a Court of Law and/or that the corner points mentioned in lines 3, 4 and 5 above were in conformance with the rules of the Michigan Board of Land Surveyors or by a Decree of a Court of Law; established, re-established, monumented, recovered, found as expressed below:

A	B	C	D	E	F	G	H	I	J	K	L	M
1												
2	6	5	4	3	2	1						
3												
4	7	8	9	10	11	12						
5												
6	18	17	16	15	14	13						
7												
8	19	20	21	22	23	24						
9												
10	30	29	28	27	26	25						
11												
12	31	32	33	34	35	36						
13												

NOTE: Not more than 2 corners, all in the same town and range, may be recorded on this certificate.

A. Description of original monument and accessories and/or subsequent restoration:

M-1	1830	GLO	Mullett	Set Post
	1978	LCRC #1203	Nederveld	Set 1/2" Rerod
	1982	LCRC #3162	Stadt	Set Kent County Monument
	1995	LCRC #8286	Byl	Kent County Monument

The position of this corner was previously approved by the Kent County Remonumentation Peer Group, monumented by Russell E. Stadt on 11/22/82 and was recorded per LCRC #3162

B. Description of corner evidence found and/or method applied in restoring or reestablishing corner:


M-1 Found standard Kent Co. Mon. (Harrison) per witnesses from above LCRC as set by Russell E. Stadt in place of the Capped Rerod he found. Rerod checks with LCRC #1203
LCRC #3162 LCRC #8286

Nail & tag P. Pole	N20°W	72.47'	Nail & tag P. Pole	N20°W	72.54'
Nail & tag 12" Walnut	S35°W	42.56'	Nail & tag 15" Walnut	S35°W	42.54'
Nail & tag 16" Oak	S20°E	69.04'	Nail & tag 24" Oak	S20°E	69.03'
Nail & tag 16" Oak	S78°E	29.70'	Nail & tag 24" Oak	S78°E	29.73'
Nail & tag 14" Oak	N15°E	113.55'	Nail & tag 20" Oak	N15°E	113.42'

The selected location is accepted by me and is generally accepted by professional surveyors as the best available evidence of the position of the original corner.

C. Description of monument for corner and accessories established to perpetuate locating the position of the corner:

M-1 Standard Kent County Monument					
Nail & KC Remon. tag E. side	P. Pole	N20°W	72.49'		
Nail & KC Remon. tag NW side	15" Walnut	S35°W	42.54'		
Nail & KC Remon. tag NE side	24" Oak	S20°E	69.03'		
Nail & KC Remon. tag N. side	24" Oak	S78°E	29.73'		
Nail & KC Remon. tag W. side	20" Oak	N15°E	113.42'		
Corner 2.5' West of C/L grav. rd.					

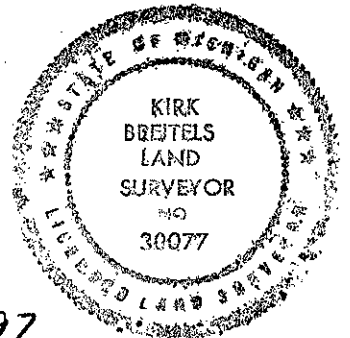

Signed by *Kirk Breitels*
Surveyor's Michigan License No. 30077

Date 3/27/97

P.A. 345 1990 KENT COUNTY
PEER APPROVED 3/27/97
CHAIRMAN *Harry Huber*