SURVEY & REMONUMENTATION

MAR 03 1998

1/2

SECTION

KENT COUNTY REMONUMENTATION

LAND CORNER RECORDATION CERTIFICATE

Filing Requirement of Act 74, Mich. P.A. 1970

For corners in KENT COUNTY (County)

	Located In:	Corner Code #
1. Public Land Survey	T 6N R 9W	M-2
	T___ R___	
	T___ R___	
	T___ R___	
2. Property Controlling	S___ T___ R___	
in Section	S___ T___ R___	
3. Miscellaneous	S___ T___ R___	
Property in Sec.	S___ T___ R___	

STATE OF MICHIGAN COUNTY OF KENT RECEIVED FOR RECORD 97 APR 29 AM 8:27 REG. OF DEEDS

9890

Register of Deeds Stamp & File Number

4. Lot No. _____, Recorded Plat _____

5. Private Claims _____

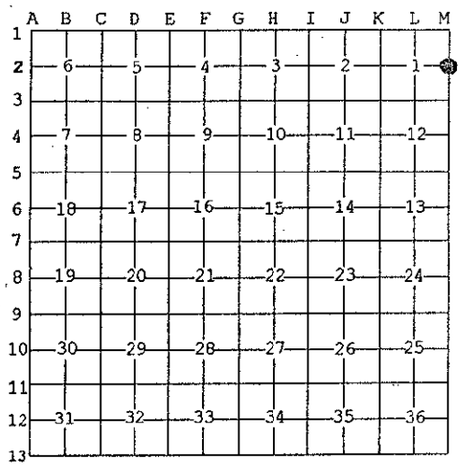

I, Kirk Breitels, in a field survey on Jan. 9, 19 97 do hereby state that under requirements of P.A. 74, Michigan P.A. of 1970, the corner points mentioned in lines 1 and 2 above were in conformance with regulations and rules therefore as required in the current manual of survey instructions of the United States Department of the Interior, Bureau of Land Management or by a decree of a Court of Law and /or that the corner points mentioned in lines 3, 4 and 5 above were in conformance with the rules of the Michigan Board of Land Surveyors or by a Decree of a Court of Law; established, re-established, monumented, recovered, found as expressed below:

NOTE: Not more than 2 corners, all in the same town and range, may be recorded on this certificate.

A. Description of original monument and accessories and/or subsequent restoration:

M-2	1830	GLO	Mullett	Set Post
	1954	Williams & Works		Iron
	1959	Kent Co. Wit.		Iron
	1985	LCRC #4136	Rosema	Set Kent County Monument
	1990	LCRC #5455	Starr	Kent County Monument

The position of this corner was previously approved by the Kent County Remonumentation Peer Group, monumented by Maurice J. Rosema on 2-4-85 and was recorded per LCRC #4136

B. Description of corner evidence found and/or method applied in restoring or reestablishing corner:

M-2 Found standard Kent Co. Mon. (Harrison) per witnesses from above LCRC as set by Maurice J. Rosema in place of the 1" Sq. Iron he found. Said Iron checks with Williams & Works information and Kent Co. Wit.

LCRC #4136

PK Nail & tag P. Pole	N05°E	72.23'
Nail & tag 12" Ash	N45°E	59.60'
Nail & tag Cl. Willows	S58°E	5.33'
Nail & tag 15" Ash	S05°E	63.34'
Nail & tag 6" Boxelder	S37°W	29.77'

LCRC #5455

same witnesses as LCRC #4136

The selected location is accepted by me and is generally accepted by professional surveyors as the best available evidence of the position of the original corner.

C. Description of monument for corner and accessories established to perpetuate locating the position of the corner:

M-2 Standard Kent County Monument

PK Nail & KC Remon. tag W. side P. Pole	N05°E	72.42' (pole leaning)
Nail & KC Remon. tag NW side 16" Ash	N45°E	59.46'
Nail & KC Remon. tag NE side cl. 20" Willows	East	6.12'
Nail & KC Remon. tag W. side 18" Ash	S05°E	63.46'
Nail & KC Remon. tag NW side 12" Boxelder	S37°W	29.85'

C/L Fulton St. - North 356'±

On tree and fence remains North and South

STATE OF MICHIGAN KIRK BREITELS LAND SURVEYOR NO 30077 LICENSED LAND SURVEYOR

Signed by Kirk Breitels

Date 3/27/97

Surveyor's Michigan License No. 30077

P.A. 345 1990 KENT COUNTY

PEER APPROVED 3/27/97

CHAIRMAN Harry Huberc

FORM APPROVED BY MICHIGAN STATE BOARD OF PROFESSIONAL SURVEYORS, JAN. 28, 1971
REVISED MAY 14, 1975
REVISED JAN., 1983
REVISED OCT., 1995