

**MAR 03 1998**

**KENT COUNTY REMONUMENTATION**

**SECTION**

**LAND CORNER RECORDATION CERTIFICATE**  
Filing Requirement of Act 74, Mich. P.A. 1970

For corners in

KENT COUNTY

(County)

Located in:

Corner Code #

- |                                    |                         |       |
|------------------------------------|-------------------------|-------|
| 1. Public Land Survey              | T <u>6N</u> R <u>9W</u> | M-6   |
|                                    | T _____ R _____         | _____ |
|                                    | T _____ R _____         | _____ |
|                                    | T _____ R _____         | _____ |
| 2. Property Controlling in Section | S _____ T _____ R _____ | _____ |
|                                    | S _____ T _____ R _____ | _____ |
| 3. Miscellaneous Property in Sec.  | S _____ T _____ R _____ | _____ |
|                                    | S _____ T _____ R _____ | _____ |

STATE OF MICHIGAN  
COUNTY OF KENT  
RECEIVED FOR RECORD  
97 APR 29 AM 8:27  
REG. OF DEEDS  
*Lucy J. Board*

**9894**

Register of Deeds Stamp & File Number

4. Lot No. \_\_\_\_\_, Recorded Plat \_\_\_\_\_  
5. Private Claims \_\_\_\_\_

I, Kirk Breitels, in a field survey on Jan. 3, 1997 do hereby state that under requirements of P.A. 74, Michigan P.A. of 1970, the corner points mentioned in lines 1 and 2 above were in conformance with regulations and rules therefore as required in the current manual of survey instructions of the United States Department of the Interior, Bureau of Land Management or by a decree of a Court of Law and /or that the corner points mentioned in lines 3, 4 and 5 above were in conformance with the rules of the Michigan Board of Land Surveyors or by a Decree of a Court of Law; established, re-established, monumented, recovered, found as expressed below:

A	B	C	D	E	F	G	H	I	J	K	L	M
1												
2	6	5	4	3	2	1						
3												
4	7	8	9	10	11	12						
5												
6	18	17	16	15	14	13						
7												
8	19	20	21	22	23	24						
9												
10	30	29	28	27	26	25						
11												
12	31	32	33	34	35	36						
13												

NOTE: Not more than 2 corners, all in the same town and range, may be recorded on this certificate.

A. Description of original monument and accessories and/or subsequent restoration:

- |     |      |            |           |                          |
|-----|------|------------|-----------|--------------------------|
| M-6 | 1830 | GLO        | Mullett   | Set Post                 |
|     | 1976 | LCRC #989  | Nederveld | 3/4" Iron                |
|     | 1981 | LCRC #2144 | Jonker    | Set Kent County Monument |
|     | 1990 | LCRC #5459 | Starr     | Kent County Monument     |

The position of this corner was previously approved by the Kent County Remonumentation Peer Group, monumented by Robert J. Jonker on 9/23/81 and was recorded per LCRC #2144

B. Description of corner evidence found and/or method applied in restoring or reestablishing corner:


M-6 Found standard Kent Co. Mon. (Harrison) per witnesses from above LCRC as set by Robert J. Jonker in place of the 3/4" Round Iron over Stone he found. Said Iron and Stone checks with LCRC #989.

- |                         |       |        |             |                              |
|-------------------------|-------|--------|-------------|------------------------------|
| LCRC #2144              |       |        |             |                              |
| Spike in 18" Walnut     | N22°W | 59.08' |             |                              |
| Remon. tag 20" Oak      | S75°E | 30.35' | "T" Iron    |                              |
| Remon. tag 9" Tw. Maple | N43°E | 39.09' | South 13.2' |                              |
| Remon. tag 30" Oak      | S41°W | 38.72' |             |                              |
| Capped Iron             | N87°W | 33.0'  |             |                              |
|                         |       |        |             | LCRC #5459                   |
|                         |       |        |             | same witnesses as LCRC #2144 |

The selected location is accepted by me and is generally accepted by professional surveyors as the best available evidence of the position of the original corner.

C. Description of monument for corner and accessories established to perpetuate locating the position of the corner:

- |     |  |       |        |  |
|-----|--|-------|--------|--|
| M-6 | Standard Kent County Monument              |       |        |  |
|     | Nail & KC Remon. tag E. side 22" Walnut    | N22°W | 58.96' |  |
|     | Nail & KC Remon. tag S. side 24" Oak       | S75°E | 30.35' |  |
|     | Nail & KC Remon. tag SE side Tw. 12" Maple | N43°E | 39.04' |  |
|     | Nail & KC Remon. tag NW side 34" Oak       | S41°W | 38.70' |  |
|     | Capped Iron                                | N87°W | 33.00' |  |
|     | "T" Iron                                   | South | 13.21' |  |
|     | On C/L N-S gravel road                     |       |        |  |

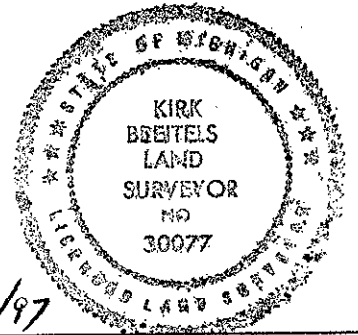

Signed by *Kirk Breitels*  
Surveyor's Michigan License No. 30077

Date 3/27/97

P.A. 345 1990 KENT COUNTY  
PEER APPROVED 3/27/97  
*Harry Huber*