SURVEY & REMONUMENTATION

MAR 0 3 1998

SECTION

7/2

KENT COUNTY REMONUMENTATION

LAND CORNER RECORDATION CERTIFICATE
Filing Requirement of Act 74, Mich. P.A. 1970

STATE OF MICHIGAN COUNTY OF KENT RECEIVED FOR RECORD
97 APR 29 AM 8:27
REG. OF DEEDS

9895
Register of Deeds Stamp & File Number

For corners in KENT COUNTY (County)

	Located In:	Corner Code #
1. Public Land Survey	T 6N R 9W	M-7
	T___ R___	
	T___ R___	
	T___ R___	
2. Property Controlling	S___ T___ R___	
in Section	S___ T___ R___	
3. Miscellaneous	S___ T___ R___	
Property in Sec.	S___ T___ R___	

4. Lot No. _____, Recorded Plat _____
5. Private Claims _____

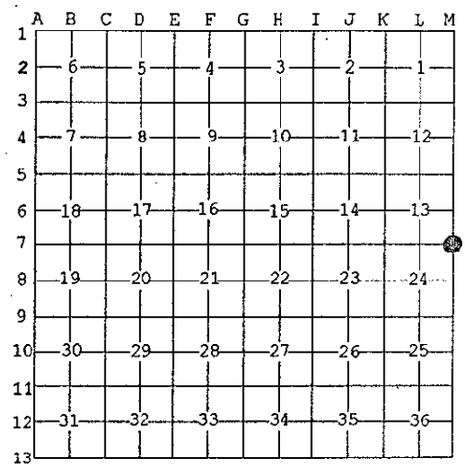

I, Kirk Breitels, in a field survey on Jan. 3, 19 97 do hereby state that under requirements of P.A. 74, Michigan P.A. of 1970, the corner points mentioned in lines 1 and 2 above were in conformance with regulations and rules therefore as required in the current manual of survey instructions of the United States Department of the Interior, Bureau of Land Management or by a decree of a Court of Law and /or that the corner points mentioned in lines 3, 4 and 5 above were in conformance with the rules of the Michigan Board of Land Surveyors or by a Decree of a Court of Law; established, re-established, monumented, recovered, found as expressed below:

NOTE: Not more than 2 corners, all in the same town and range, may be recorded on this certificate.

A. Description of original monument and accessories and/or subsequent restoration:

M-7	1830	GLO	Mullett	Set Post
	1939	Kent Co. Wit.		Monument
	1972	Williams & Works		Iron
	1985	LCRC #4164	Rosema	Set Kent County Monument
	1990	LCRC #5460	Starr	Kent County Monument

The position of this corner was previously approved by the Kent County Remonumentation Peer Group, monumented by Maurice J. Rosema on 4/1/85 and was recorded per LCRC #4164

B. Description of corner evidence found and/or method applied in restoring or reestablishing corner:

M-7 Found BROKEN standard Kent Co. Mon. (Harrison) per witnesses from above LCRC as set by Maurice J. Rosema in place of the 1" Iron he found. Said Iron checks with Kent Co. Wit. and Williams & Works information. RESET standard Kent Co. Mon. per witnesses.

LCRC #4164			LCRC #5460
Nail & tag 18" Maple	S06°W	37.82'	same witnesses as LCRC #4164
Nail & tag Tw. 12" Walnut	S20°E	21.15'	
Nail & tag 15" Walnut	N19°W	46.52'	
Nail & tag 12" Walnut	N55°W	50.72'	
Nail & tag 12" Maple	S57°W	49.90'	

The selected location is accepted by me and is generally accepted by professional surveyors as the best available evidence of the position of the original corner.

C. Description of monument for corner and accessories established to perpetuate locating the position of the corner:

M-7 Standard Kent County Monument

Nail & KC Remon. tag W. side 20" Maple	S06°W	37.88'
Nail & KC Remon. tag NE side Tw. 18" Walnut	S20°E	21.15'
Nail & KC Remon. tag NE side 18" Walnut	N19°W	46.56'
Nail & KC Remon. tag SW side 15" Walnut	N55°W	50.72'
Nail & KC Remon. tag SE side 16" Maple	S57°W	49.90'
PK Nail NW side P. Pole	N50°E	42.29'

On C/L E-W grav. rd. and C/L grav. rd. N. is E. 4'±

STATE OF MICHIGAN KIRK BREITELS LAND SURVEYOR No 30077 LICENSED LAND SURVEYOR

Signed by Kirk Breitels Date 3/27/97

Surveyor's Michigan License No. 30077

P.A. 345 1990 KENT COUNTY
PEER APPROVED 3/27/97
CHAIRMAN Larry Hukeer

FORM APPROVED BY MICHIGAN STATE BOARD OF PROFESSIONAL SURVEYORS, JAN. 28, 1971
REVISED MAY 14,1975
REVISED JAN., 1983
REVISED OCT., 1995