

SURVEY & REMONUMENTATION

SEP 01 1994

COMMISSION

**Kent County remonumentation
LAND CORNER RECORDATION CERTIFICATE**

STATE OF MICHIGAN
COUNTY OF KENT
RECEIVED FOR RECORD

Filing Requirement of Act 74, Mich. P.A. 1970

94 AUG 22 PM 2: 34

For corners in

Kent
(County)

Lowell Township

Located In:

Corner Code #

1. Public Land Survey	T	6N	R	9W	M-8
	T		R		
	T		R		
	T		R		
2. Property Controlling in Section	S		T	R	Seg. #1
	S		T	R	
3. Miscellaneous Property in Sec.	S		T	R	
	S		T	R	

Tim J. Bond
REG. OF DEEDS

6967

Register of Deeds Stamp & File Number

4. Lot No. _____, Recorded Plat _____
5. Private Claims _____

I, Maurice J. Rosema in a field survey on Jan. 22, 19 93, do hereby certify that under requirements of P.A. 74, Michigan P.A. of 1970, the corner points mentioned in lines 1 and 2 above were in conformance with regulations and rules therefore as required in the current manual of survey instructions of the United States Department of the Interior, Bureau of Land Management or by a decree of a Court of Law and/or that the corner points mentioned in lines 3, 4 and 5 above were in conformance with the rules of the Michigan Board of Land Surveyors or by a Decree of a Court of Law; established, re-established, monumented, re-monumented, recovered, found as expressed below:

	A	B	C	D	E	F	G	H	I	J	K	L	M
2	6		5		4		3		2		1		
3													
4	7		8		9		10		11		12		
5													
6	18		17		16		15		14		13		
7													
8	19		20		21		22		23		24		
9													
10	30		29		28		27		26		25		
11													
12	31		32		33		34		35		36		
13													

NOTE: Not more than 4 corners, all in the same town and range, may be recorded on this certificate.

A. Description of original monument and accessories and/or subsequent restoration:

M-8
G.L.O. set wood stake
No other information available from the County Surveyor's Office, other surveying firms or any other sources.

P.A. 345 1990 KENT COUNTY
PEER APPROVED March 9, 93
CHAIRMAN Harry Huber

B. Description of corner evidence found and/or method applied in restoring or reestablishing corner:


M-8
NO evidence found. Determined that M-8 should be set at the mid-point of a straight line from M-7 (std. K.C. mon.) to M-9 (std. K.C. mon.). Corner M-8 lies in pond, set std. K.C. mon. 193.00' North of M-8 on said line between M-7 and M-9.

Field checked June 29, 1994, the monument is in place and all witnesses as shown on cert. no. 6746, recorded March 26, 1993 check.

This corner is re-recorded to correct cert. no. 6746.

C. Description of monument for corner and accessories established to perpetuate locating the position of the corner:

M-8
Set std. K.C. monument 193.00' North of M-8 (4" x 30" Harrison)
East edge of East rail (of railroad track) - N60°W 10.59'
Nail and K.C. tag in S. side tw. 6" Oak - N80°W 55.02'
Nail and K.C. tag in NE. side T. pole - N15°W 50.73'
Nail and K.C. tag in NE. side 6" Ash - N5°E 114.21'
centerline of E.-W. creek N20°E 80'±
M-7 (std. K.C. mon.) - N00°E 2447.24'
M-9 (std. K.C. mon.) - S00°E 2833.24'

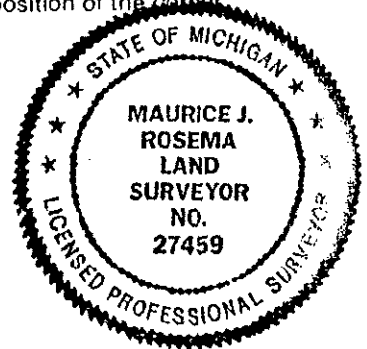

Signed by Maurice J. Rosema
Surveyor's Michigan License No. 27459

Date August 17, 1994