

**SURVEY & REMONUMENTATION**

MAR 03 1998

**KENT COUNTY REMONUMENTATION**

**SECTION**

**LAND CORNER RECORDATION CERTIFICATE**  
Filing Requirement of Act 74, Mich. P.A. 1970

For corners in  
**KENT COUNTY**

(County)

Located In:

Corner Code #

1. Public Land Survey

T 6N R 9W  
T \_\_\_\_\_ R \_\_\_\_\_  
T \_\_\_\_\_ R \_\_\_\_\_  
T \_\_\_\_\_ R \_\_\_\_\_  
S \_\_\_\_\_ T \_\_\_\_\_ R \_\_\_\_\_  
S \_\_\_\_\_ T \_\_\_\_\_ R \_\_\_\_\_  
S \_\_\_\_\_ T \_\_\_\_\_ R \_\_\_\_\_  
S \_\_\_\_\_ T \_\_\_\_\_ R \_\_\_\_\_

M-9  
\_\_\_\_\_  
\_\_\_\_\_  
\_\_\_\_\_  
\_\_\_\_\_  
\_\_\_\_\_  
\_\_\_\_\_  
\_\_\_\_\_

*Seg. #2*

2. Property Controlling in Section

3. Miscellaneous Property in Sec.

4. Lot No. \_\_\_\_\_, Recorded Plat \_\_\_\_\_

5. Private Claims \_\_\_\_\_

STATE OF MICHIGAN  
SOLICITOR GENERAL  
RECEIVED FOR RECORD  
97 OCT 14 AM 10:01  
REG. OF DEEDS  
*Lucy Bond*

**10047**

Register of Deeds Stamp & File Number

I, Kirk Breitels

in a field survey on Aug. 15, 1997 do hereby state that under requirements of P.A. 74, Michigan P.A. of 1970, the corner points mentioned in lines 1 and 2 above were in conformance with regulations and rules therefore as required in the current manual of survey instructions of the United States Department of the Interior, Bureau of Land Management or by a decree of a Court of Law and /or that the corner points mentioned in lines 3, 4 and 5 above were in conformance with the rules of the Michigan Board of Land Surveyors or by a Decree of a Court of Law; established, re-established, monumented, recovered, found as expressed below:

NOTE: Not more than 2 corners, all in the same town and range, may be recorded on this certificate.

A	B	C	D	E	F	G	H	I	J	K	L	M
1												
2	6	5	4	3	2	1						
3												
4	7	8	9	10	11	12						
5												
6	18	17	16	15	14	13						
7												
8	19	20	21	22	23	24						
9												
10	30	29	28	27	26	25						
11												
12	31	32	33	34	35	36						
13												

A. Description of original monument and accessories and/or subsequent restoration:

M-9	1830	GLO	Mullett	Set Post
		Kent Co. Wit.		1" Iron
	1974	LCRC #633	Spicer	1" Iron
	1982	LCRC #3102	Merdzinski	Set Kent County Monument
	1990	LCRC #5461	Starr	Kent County Monument
	1996	LCRC #9896	Breitels	Kent County Monument

The position of this corner was previously approved by the Kent County Remonumentation Peer Group, monumented by John A. Merdzinski on 10-15-82 and was recorded per LCRC #3102


B. Description of corner evidence found and/or method applied in restoring or reestablishing corner:

M-9 On May 22, 1997, new information was presented to the Kent Co. Remon. Peer Group that the Kent Co. Monument as approved and set and recorded per LCRC #3102, #5461, #9896 may be incorrect and that a RR Rail 13.11' South of the present Kent Co. Monument may be the correct corner, based on measurement comparison of an 1891 survey found at Ionia County and the GLO jog (13.20'). After further investigation, on June 26, 1997, documents provided by Earthtech (Williams & Works) show that in 1895 they set a "RR Rail 20 links (13.2') South of the Boston Twp. corner." The Kent Co. Remon. Peer Group approved the RR Rail as the correct corner. I was instructed to monument M-9 on the extended Township line 13.11' South of and through the incorrect M-9 (now A-9, T6N, R8W) location. Doing so, I found the RR rail (24" deep) to be ± 0.4' East of this position. The selected location is accepted by me and is generally accepted by professional surveyors as the best available evidence of the position of the original corner.

C. Description of monument for corner and accessories established to perpetuate locating the position of the corner:

M-9 Set Standard Kent County Monument on Twp. line next to RR Rail

SW corner concrete block building	N35°E	96.86'
Nail & KC Remon. tag W. side 34" Walnut	N35°W	52.42'
Nail & KC Remon. tag W. side P & T Pole	N05°E	66.37'
Nail & KC Remon. tag E. side P & T Pole	S30°W	45.56'
NW corner frame house	S50°E	80.09'
Harrison Monument (A-8, T6N, R8W)	North	13.11'
On tree row North and C/L grav. rd. South is 5' ± East		

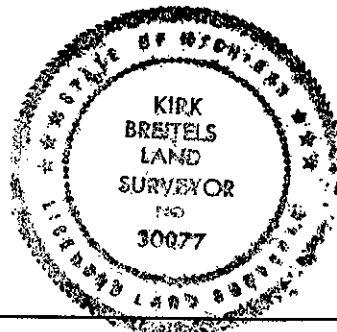

Signed by *Kirk Breitels*

Date 8/28/97

Surveyor's Michigan License No. 30077

P.A. 345 1990 KENT COUNTY  
PEER APPROVED 6/26/97  
CHAIRMAN *Harry Hubert*